


T.29S.R.12W.W.M.

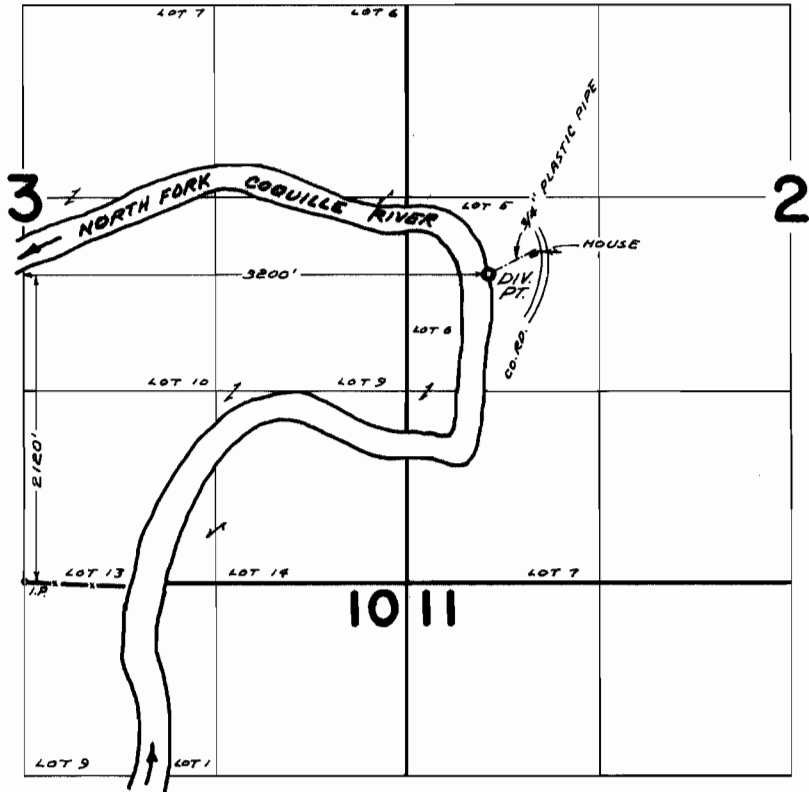

FINAL PROOF SURVEY UNDER

Application No. 39515 Permit No. 29475
IN NAME OF

KEITH D. NEAL

Surveyed SEP. 16 1989, by D. BUELL