


T.28&29S.R.12W.W.M.

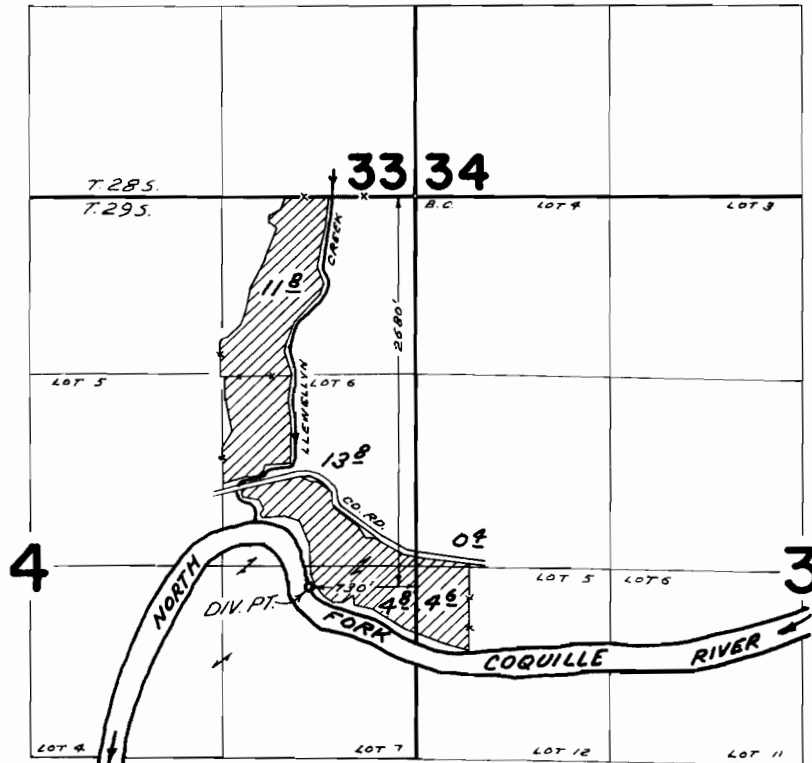

**FINAL PROOF SURVEY**  
UNDER

Application No. 39651 Permit No. 29618  
IN NAME OF

*ELLIS SOUTHMAYD*

Surveyed SEP. 16, 1969, by D. BUELL