


T. 28 S. R. 11 W. W. M.

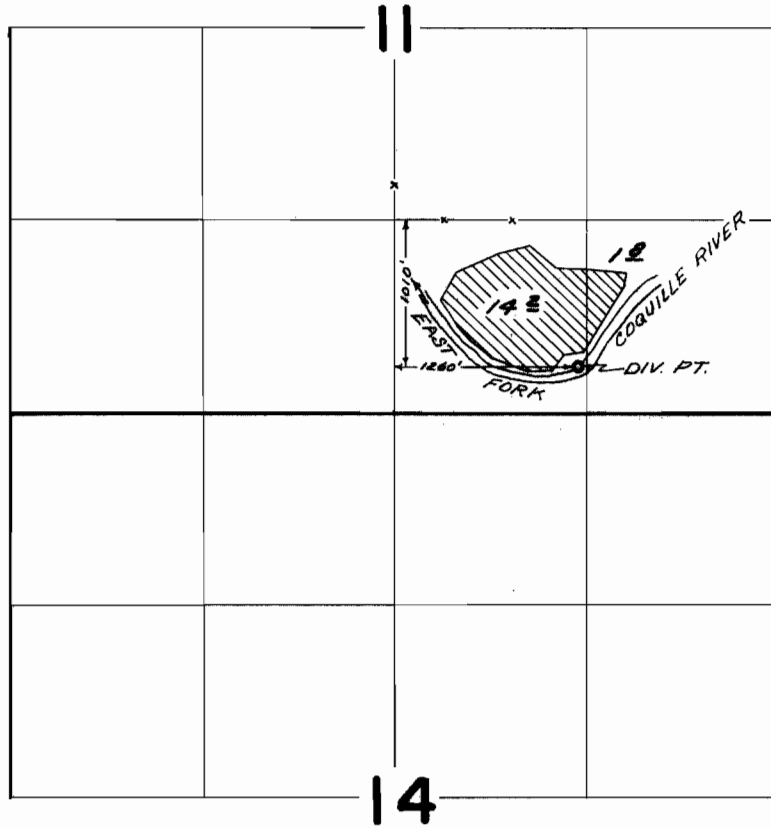

**FINAL PROOF SURVEY**  
UNDER

Application No. 39872 Permit No. 29677  
IN NAME OF

LLOYD HALL

Surveyed SEP. 15 1969, by D. BUELL