


T. 29S. R. 12W. W.M.

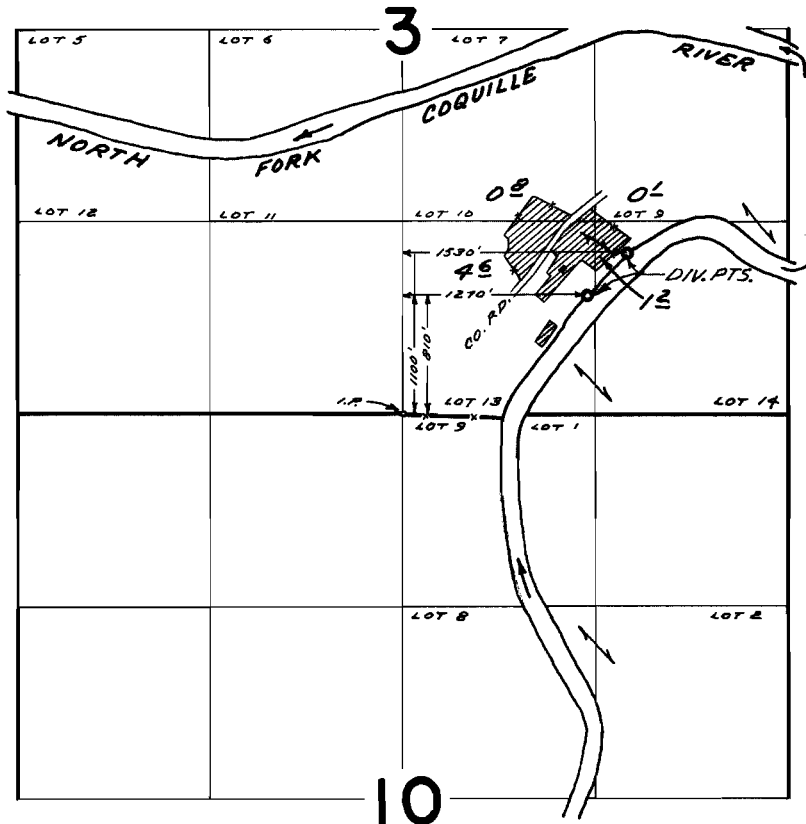

**FINAL PROOF SURVEY**  
UNDER

Application No. 41068 Permit No. 30599  
IN NAME OF

JESSE H. FREEMAN

Surveyed AUG. 20 1969, by D. BUELL