


T.29S.R.13W.W.M.

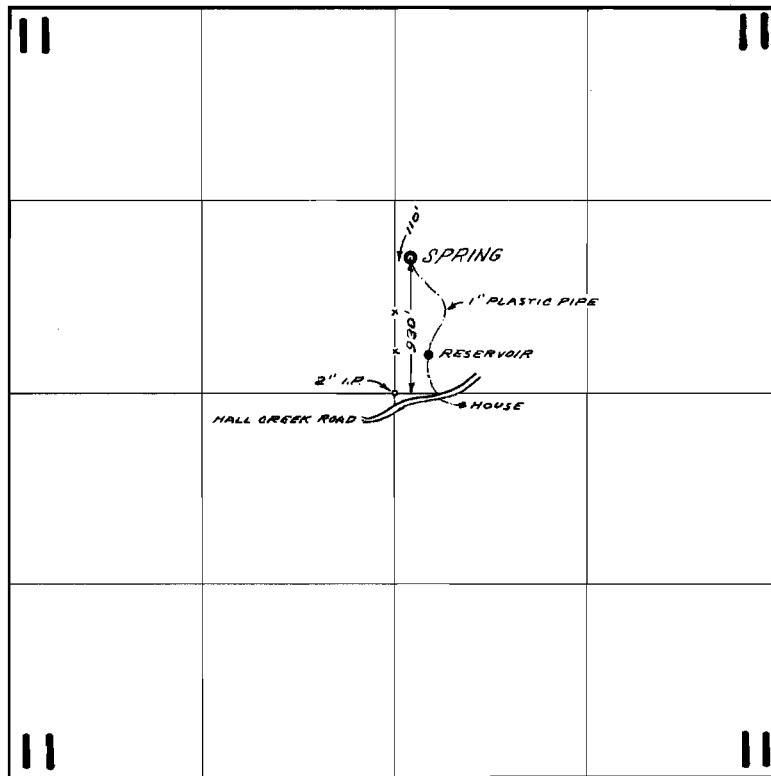

**FINAL PROOF SURVEY**  
UNDER

Application No. 44780 Permit No. 33056  
IN NAME OF

ALBERT F. TOMLINSON

Surveyed SEP. 11 1969, by D. BUELL