


T.17S.R.21E.W.M.

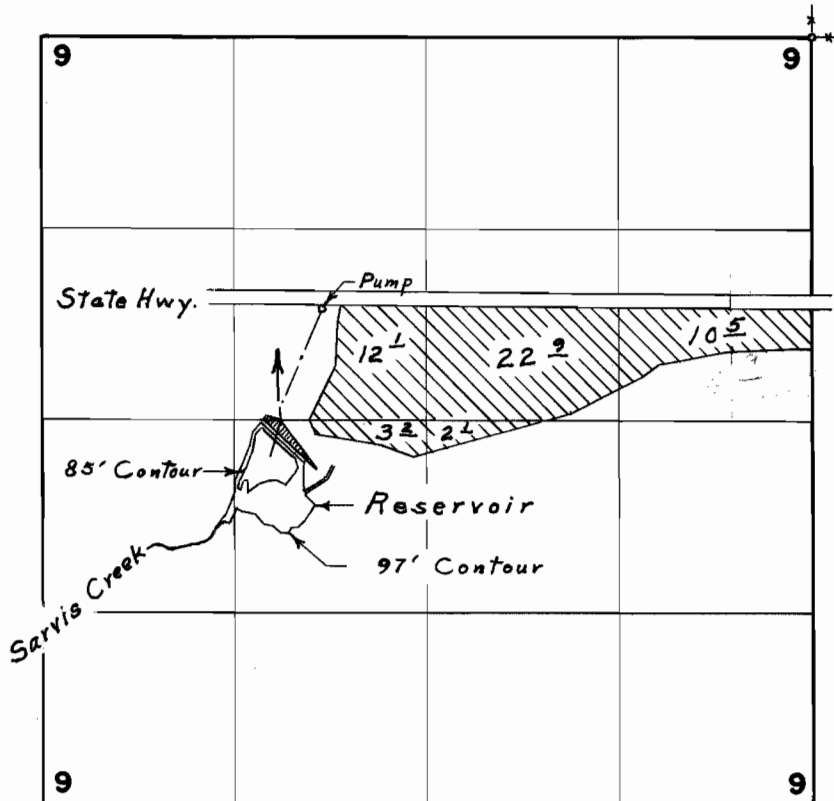

Div. Pt. located 2730' S. & 3670' W. from N.E. Cor. Sec. 9

C-27519

FINAL PROOF SURVEY UNDER

R-42374 R-4760
Application No. 42375 Permit No. 31340
IN NAME OF

MAINLINE RANCH, INC.

Surveyed Oct. 31, 1968, by L. E. Gould