


T.17S.R.12E.W.M.

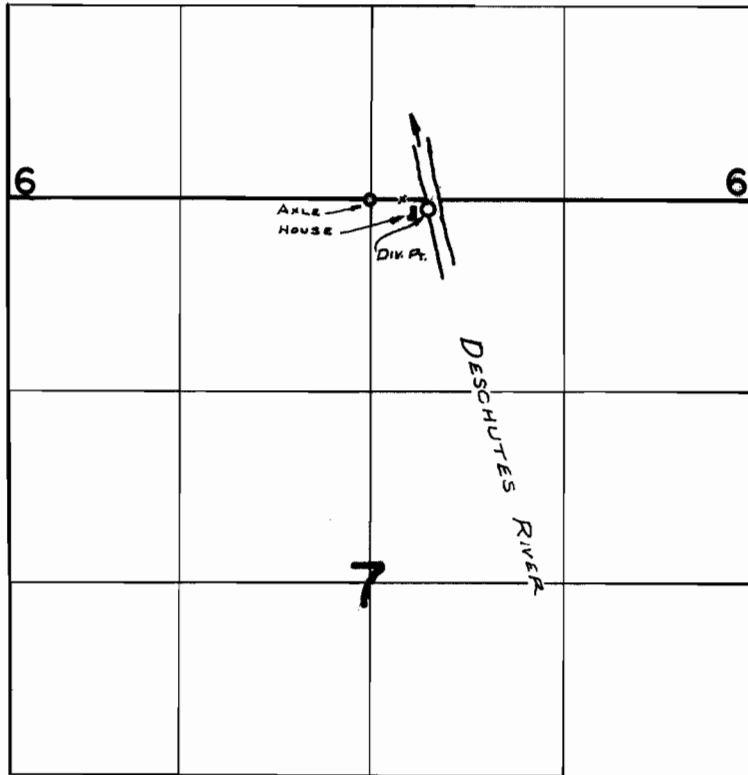

DIV. Pt. LOC: 60'S. & 380'E. FROM N. 1/4 COR. SEC. 7

**FINAL PROOF SURVEY**  
UNDER

Application No. 39780 Permit No. 29576  
IN NAME OF

H. NORMAN COWAN & LOUISE COWAN

Surveyed SEPT. 30, 1969, by D. BUELL