


T. 30 S. R. 5 W. W.M.

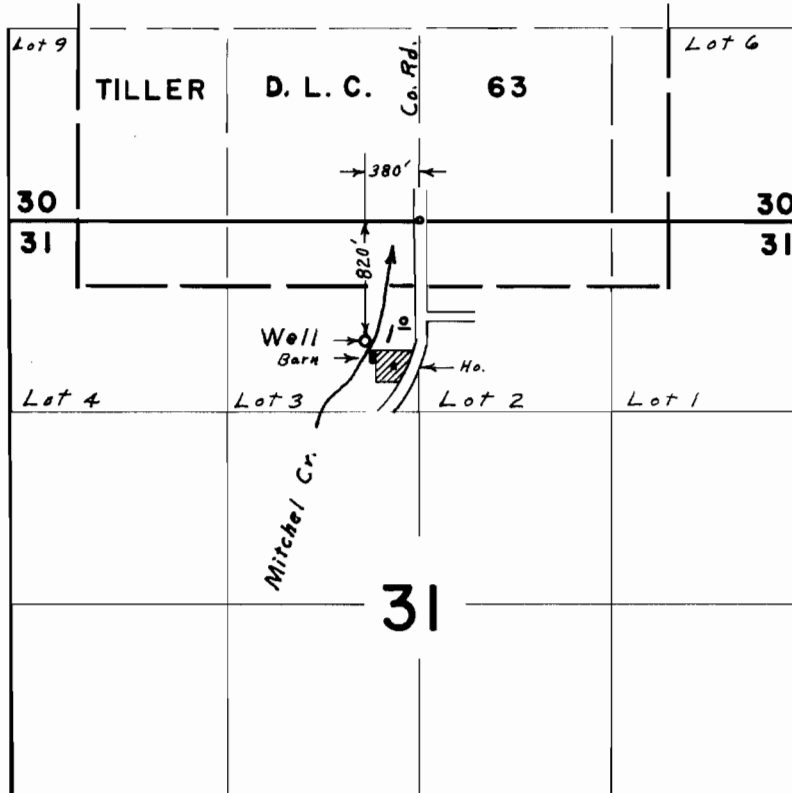

**FINAL PROOF SURVEY**  
UNDER

Application No. G-3206 Permit No. G-3003  
IN NAME OF

WILLIAM R. THOMPSON

Surveyed July 30, 1969, by L. E. Gould