


T.29S.R.5W.W.M.

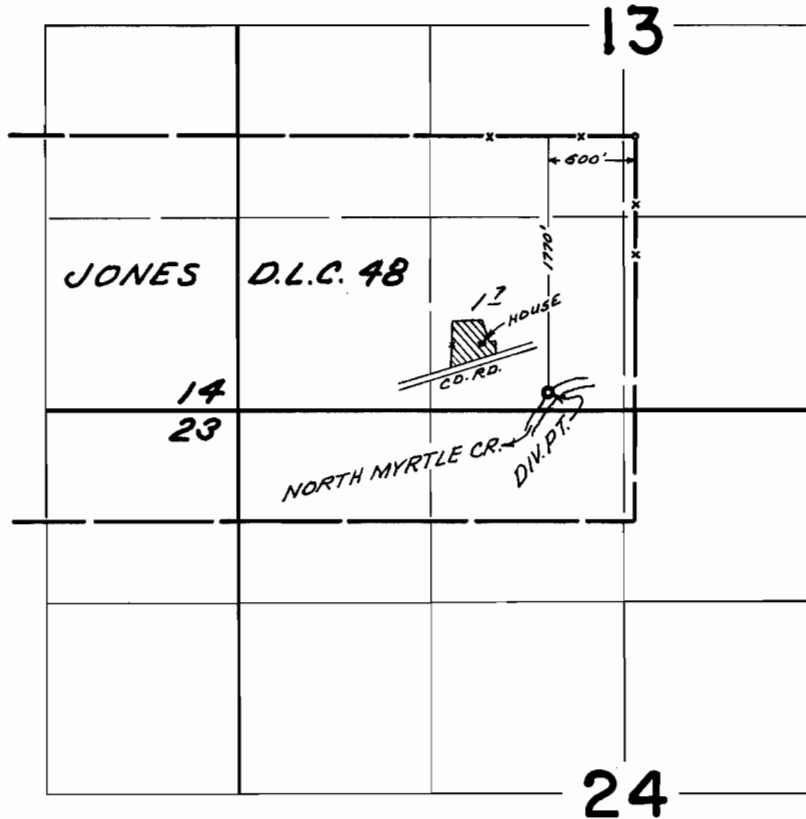

**FINAL PROOF SURVEY**  
UNDER

Application No. 41012 Permit No. 30577  
IN NAME OF

GARY A. BROWN

Surveyed JUN 25 1969, by D. BUELL