


T. 30 S. R. 5 W. W. M.

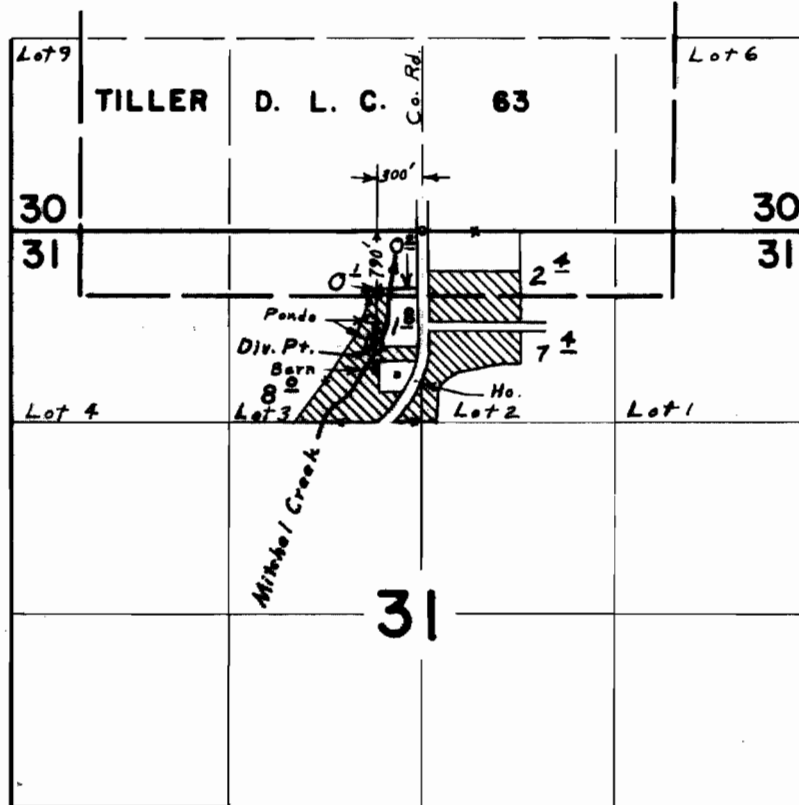

FINAL PROOF SURVEY UNDER

Application No. 41268 Permit No. 30774
IN NAME OF

WILLIAM R. THOMPSON

Surveyed July 30, 1969, by L. E. Gould