


T. 29 S. R. 7 W. W.M.

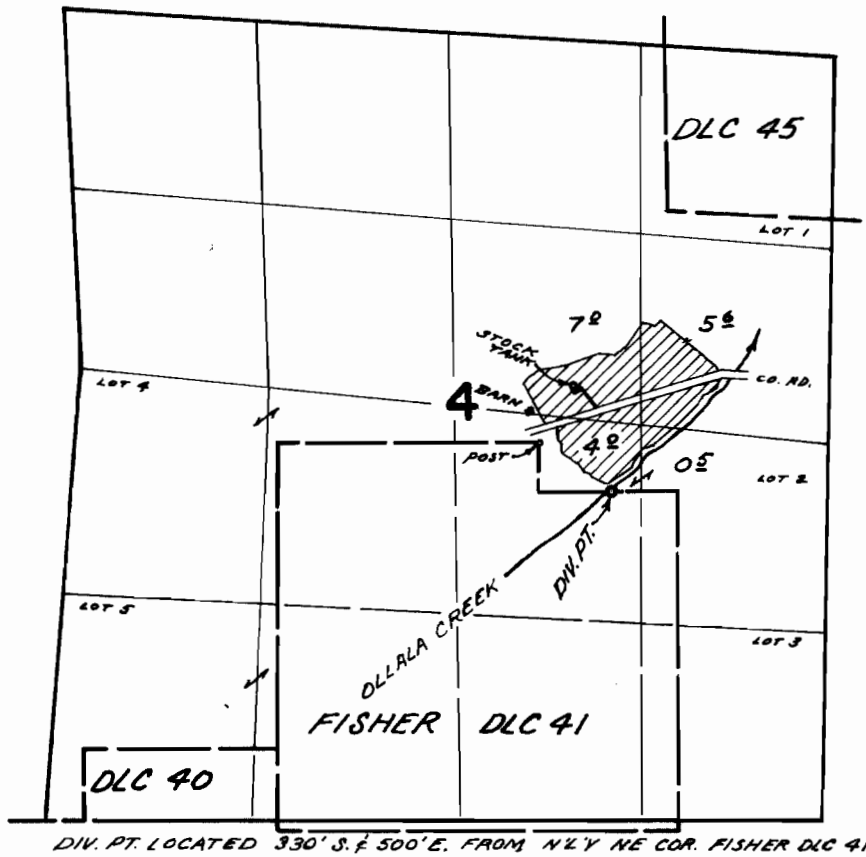

FINAL PROOF SURVEY
UNDER

Application No. 43497 Permit No. 32535
IN NAME OF
BENTON LEE AND ELAINE REDING
Surveyed AUG 1 1969, by D. BUELL