


T. 27 S. R. 6 W. W.M.

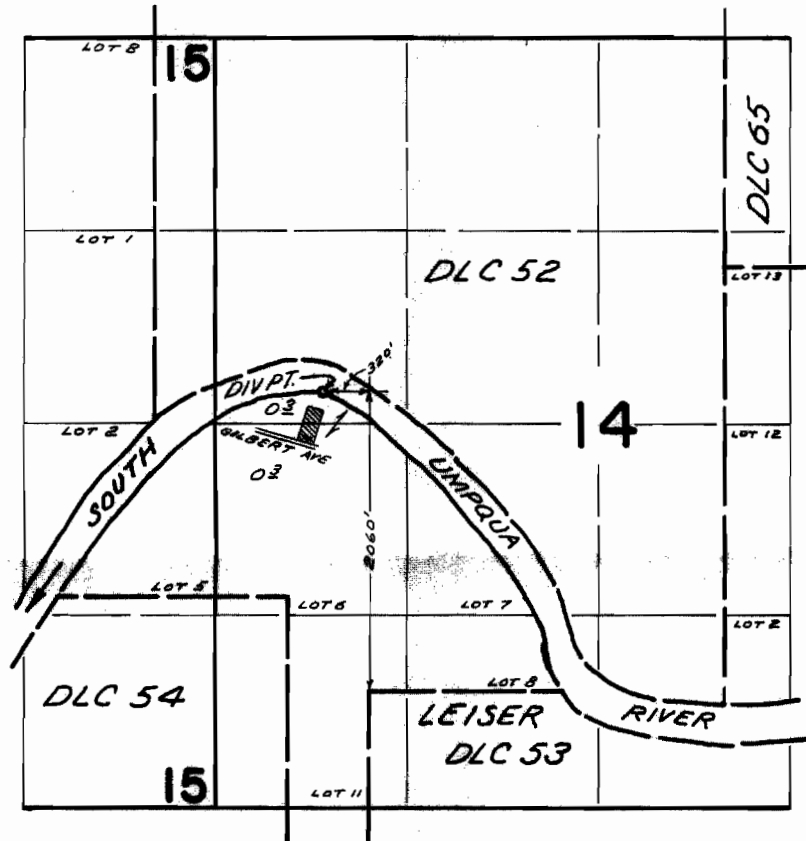

FINAL PROOF SURVEY UNDER

Application No. 43664 Permit No. 32692
IN NAME OF

EUGENE T. AND MARGARET J. KREWSON

Surveyed APR. 15 1969, by D. BUELL