
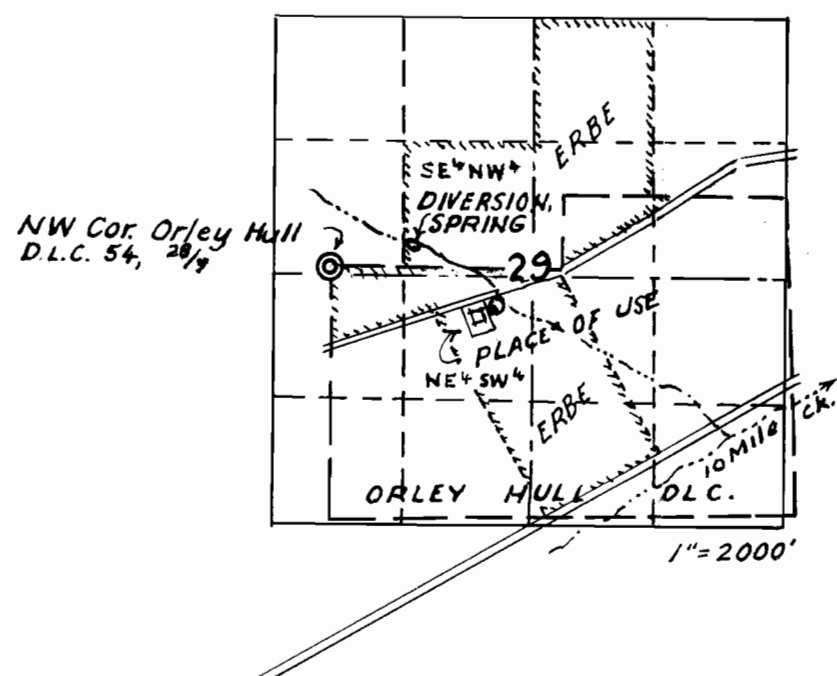


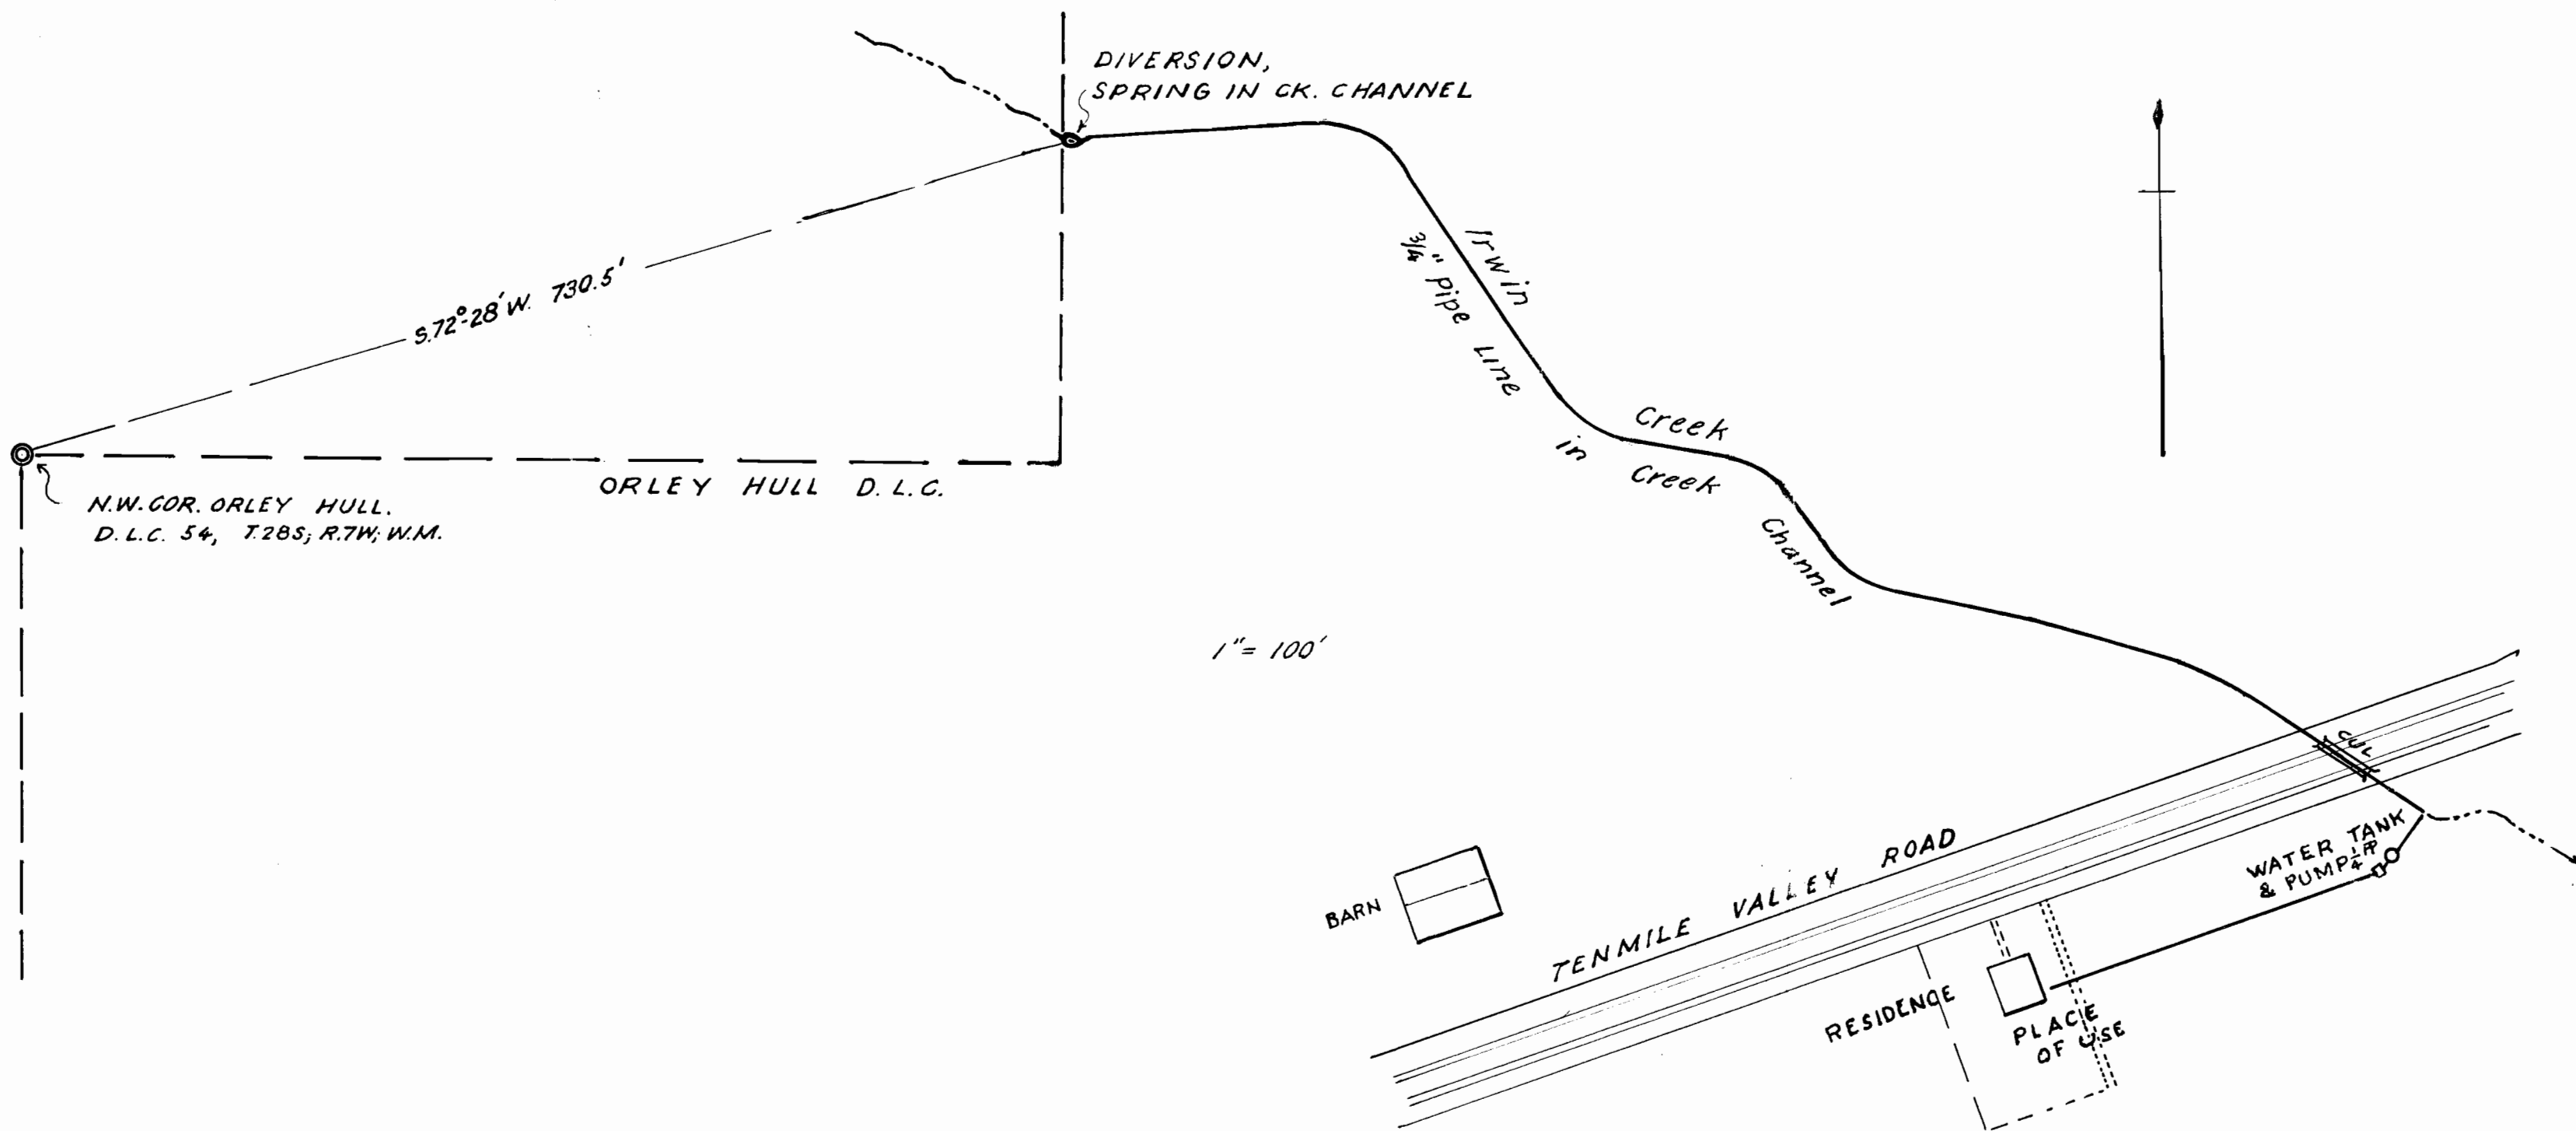

RECEIVED
APR 10 1968
33532

W. H. ERBE, RT. 4, BOX 800, ROSEBURG, ORE.	
APPLICATN. FOR PERMIT FOR USE OF WATER FOR DOMESTIC PURPOSES, INCL. LIVESTOCK, FROM SPRING IN IRWIN CK, SEC. 29, T.28S; R.7W; W.M., DOUGLAS COUNTY, ORE.	
APR. 1968.	SCALES AS SHOWN