


T. 23S.R. 7W.W.M.

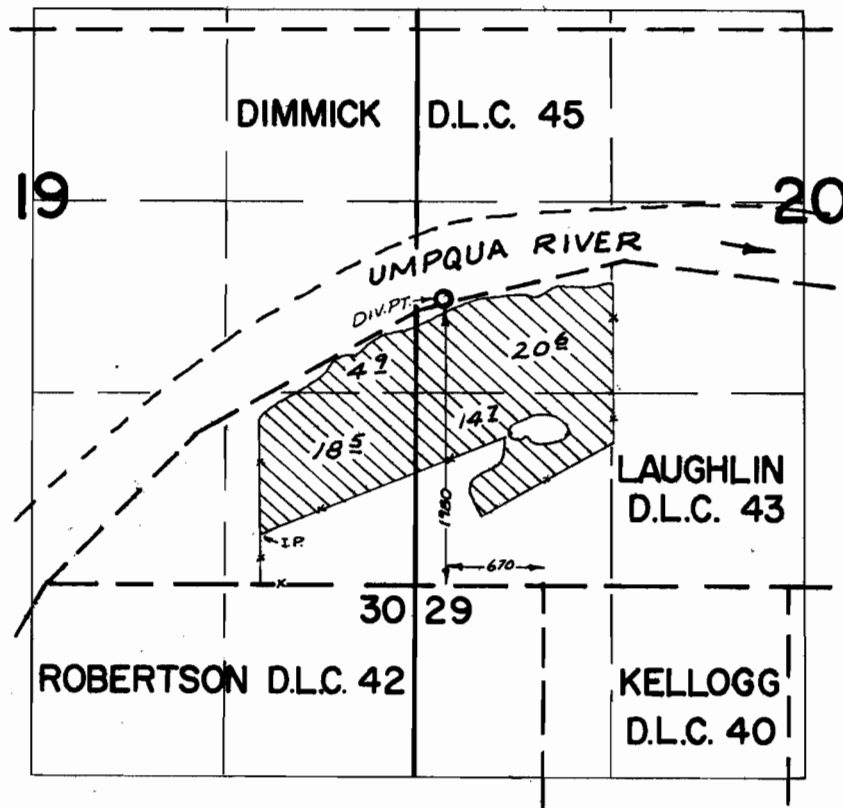

FINAL PROOF SURVEY

UNDER

Application No. 44952 Permit No. 33600

IN NAME OF

HOWARD E. CARNES

Surveyed JUNE 3, 1970, by R. MUCKEN