


Twn. 2 S. R44E.

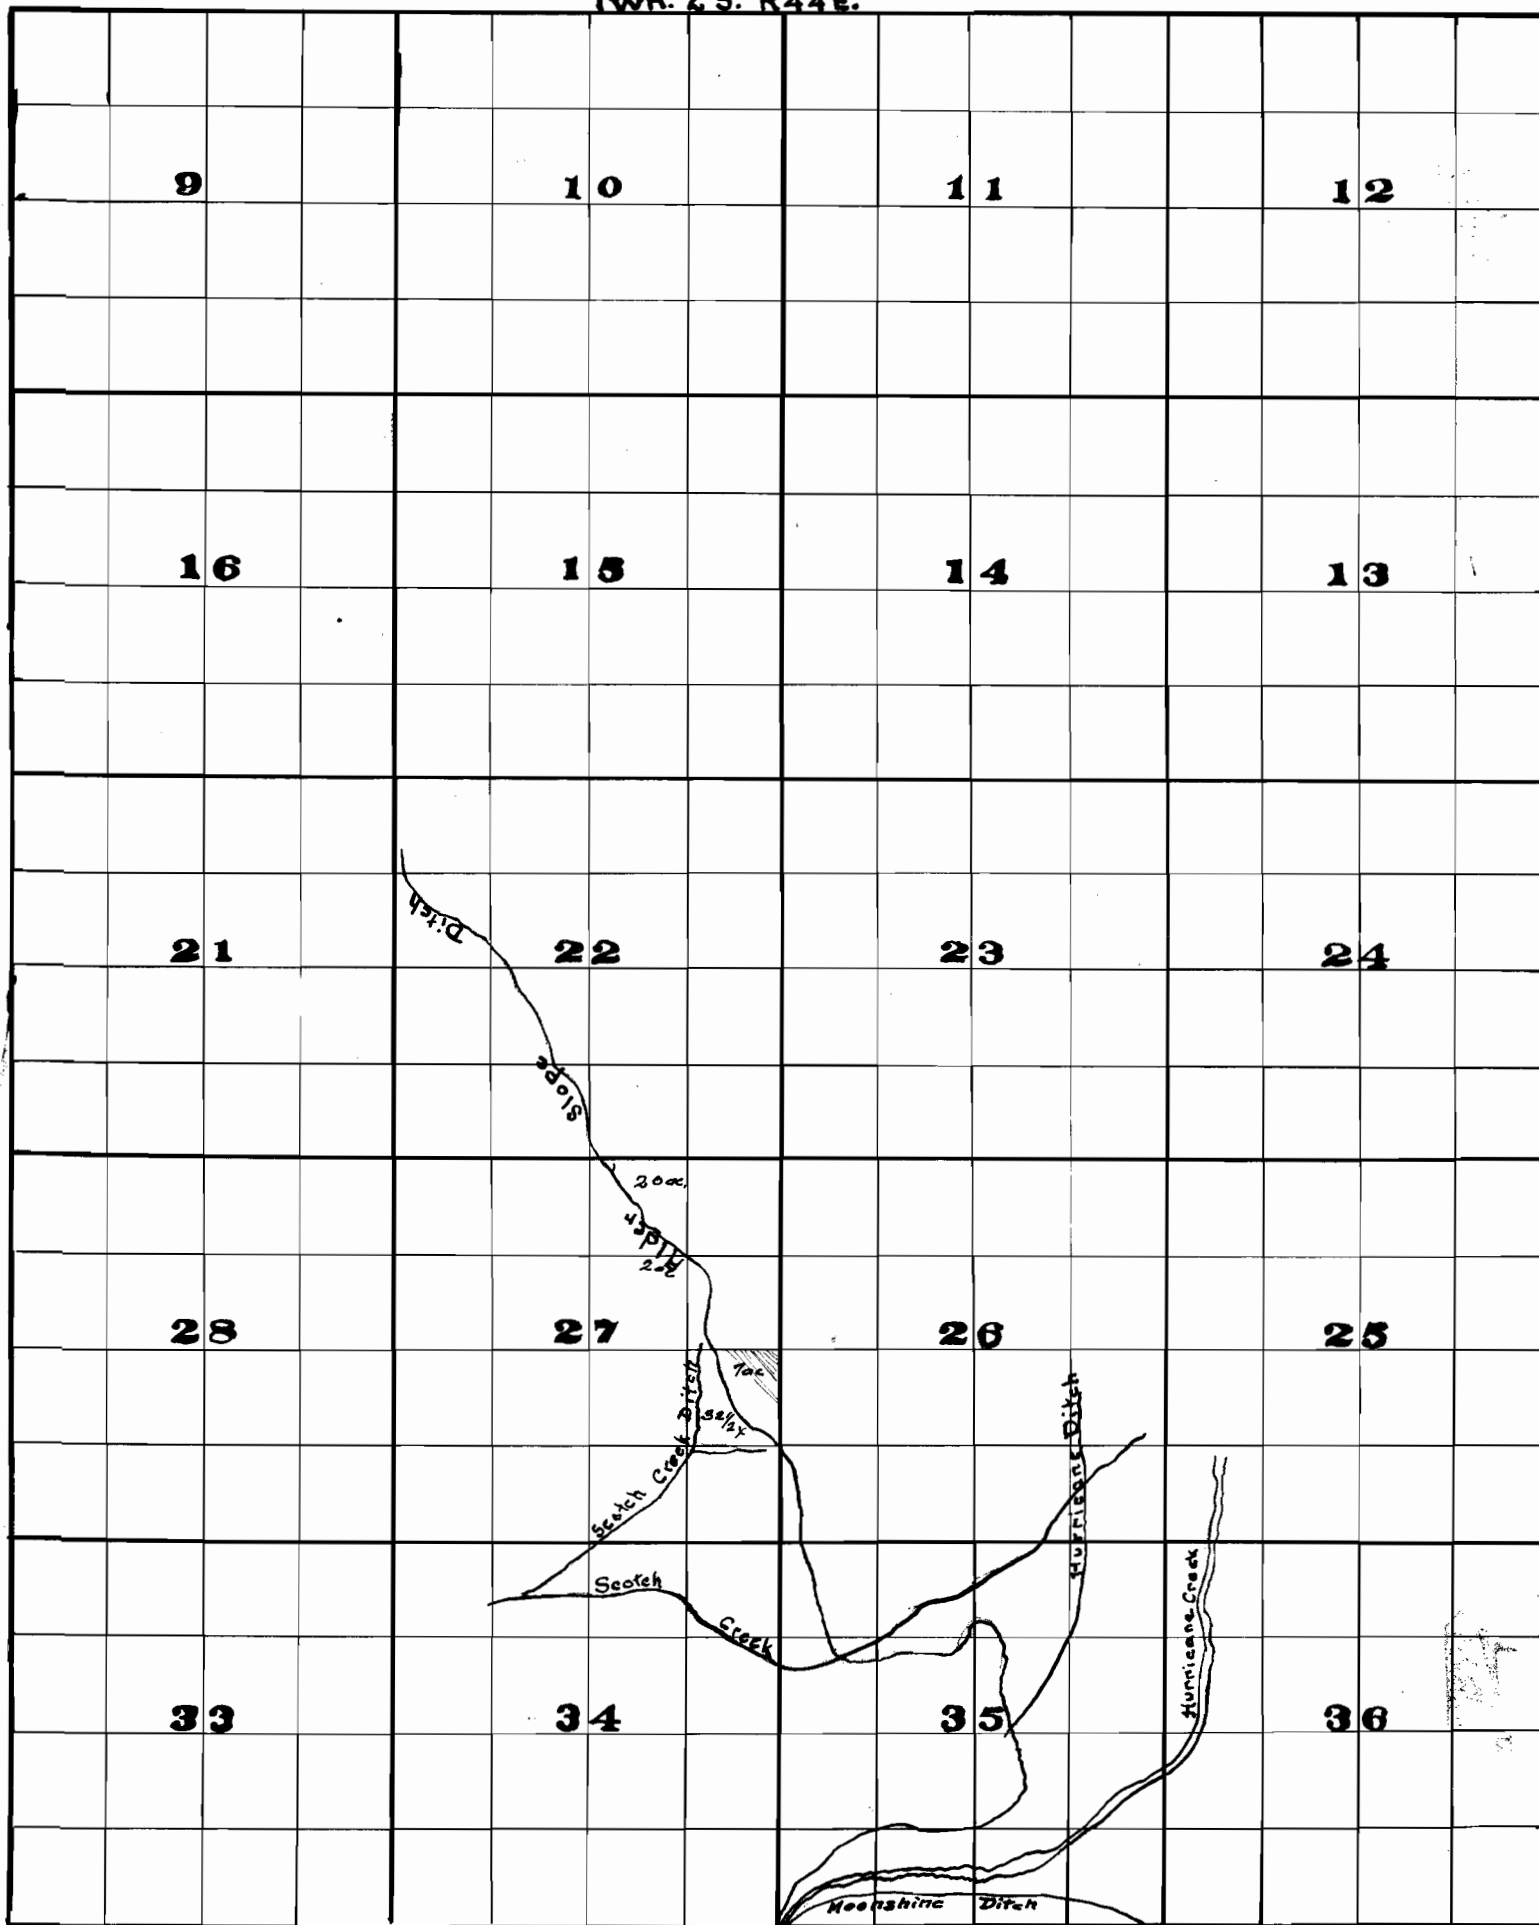

I Geo. H. Brewster of Endicott, N.Y. do hereby certify that this map was drawn from the state maps prepared in the Wallowa River adjudication.

Geo. H. Brewster
 Notary Public
 State of New York
 1030
 1030

Application No. 7193
 Permit No. 4529 4529