


T.35S.R.2W.W.M.

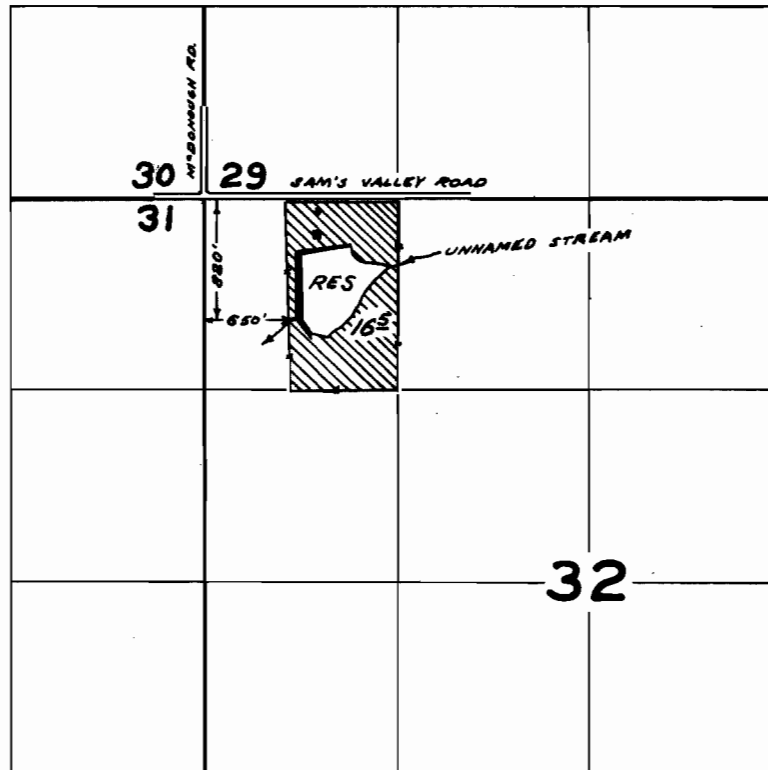

FINAL PROOF SURVEY
UNDER

Application No. R-40219 40220 Permit No. R-4140 29820
IN NAME OF

MRS. JUANITA F. BUSH

Surveyed JUN. 7 1968 by V. GARNER