


T. 37S. R. 5W. W.M.

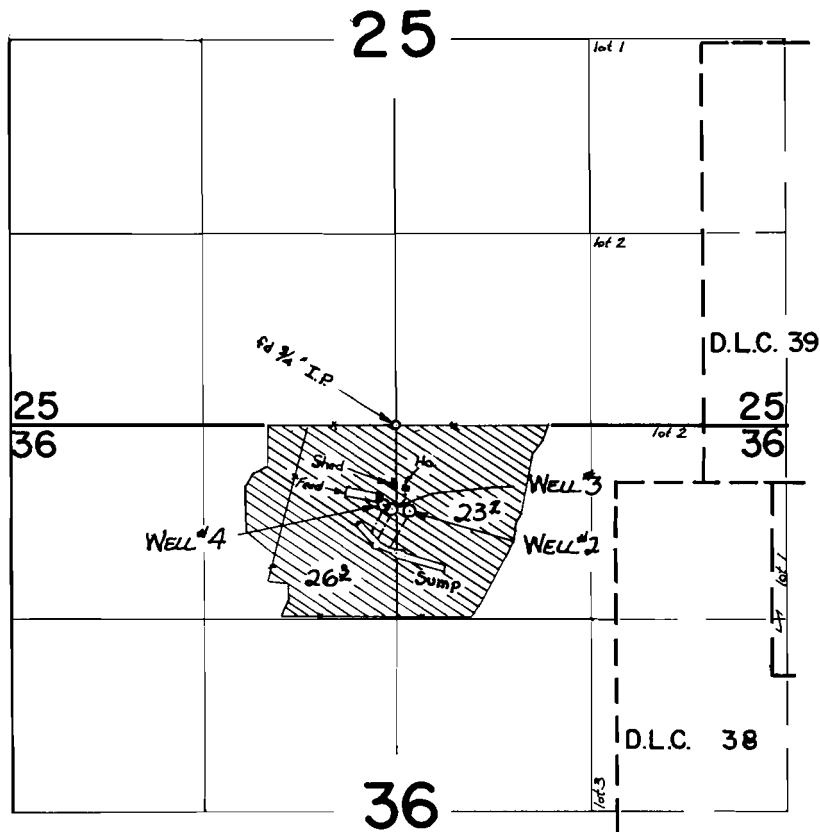

Well #2 located 580'S & 80'E, Sump located 880'S both from
N 1/4 Cor Sec 36, 3/4" I.P. Well #3, 570'S & 40'W; Well #4,
530'S & 90'W; both from N 1/4 cor. Sec. 36

FINAL PROOF SURVEY
UNDER

G-5095 G-4809
Application No. G 3419 Permit No. G 3205
IN NAME OF

JACK A. BENNETT

Surveyed 30 APRIL 1970, by D.R. BUELL
SEPT. 16, 1974 L. TOLL