


T. 33 S. R. 6 W. W.M.

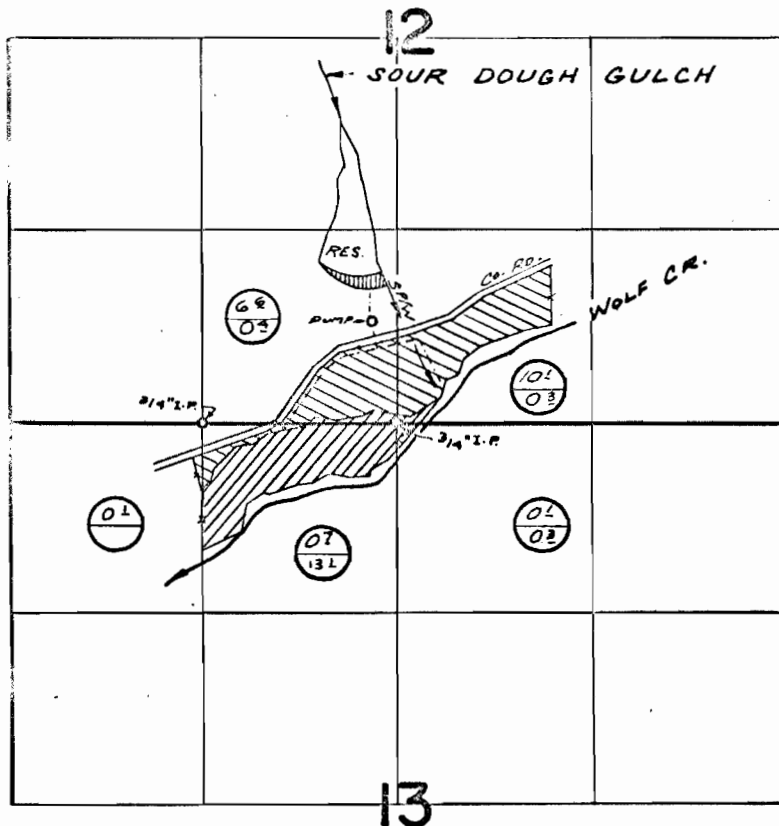

DIV. PT. LOC: 960' N. & 180' W. FROM S. 1/4 COR. SEC. 12



FINAL PROOF SURVEY UNDER

Application No. R-37558 37559 Permit No. R-4458 29884
IN NAME OF

ROGER L. STRONG

Surveyed APR. 30, 1970, by R. MURKIN