


T. 36 S. R. 7 W. W.M.

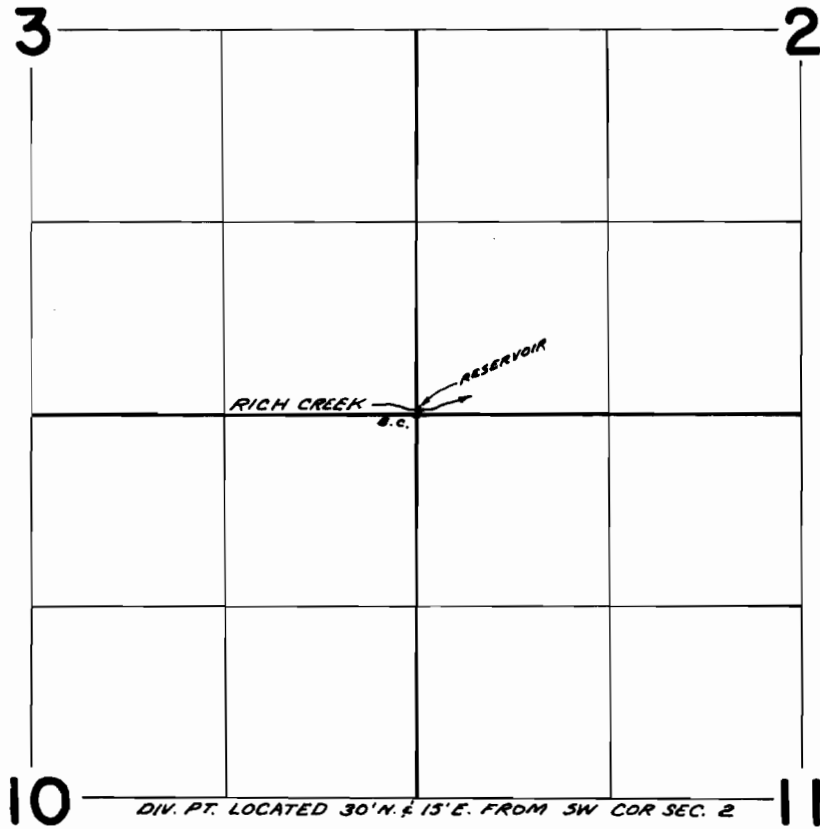

**FINAL PROOF SURVEY**  
UNDER

Application No. 42440 Permit No. 31342  
R-42551 R-4752  
IN NAME OF

CHARLES E. & MARY TOTH SMITH

Surveyed JUN. 6 1969, by D. BUELL