


T. 36 S. R. 7 W. W. M.

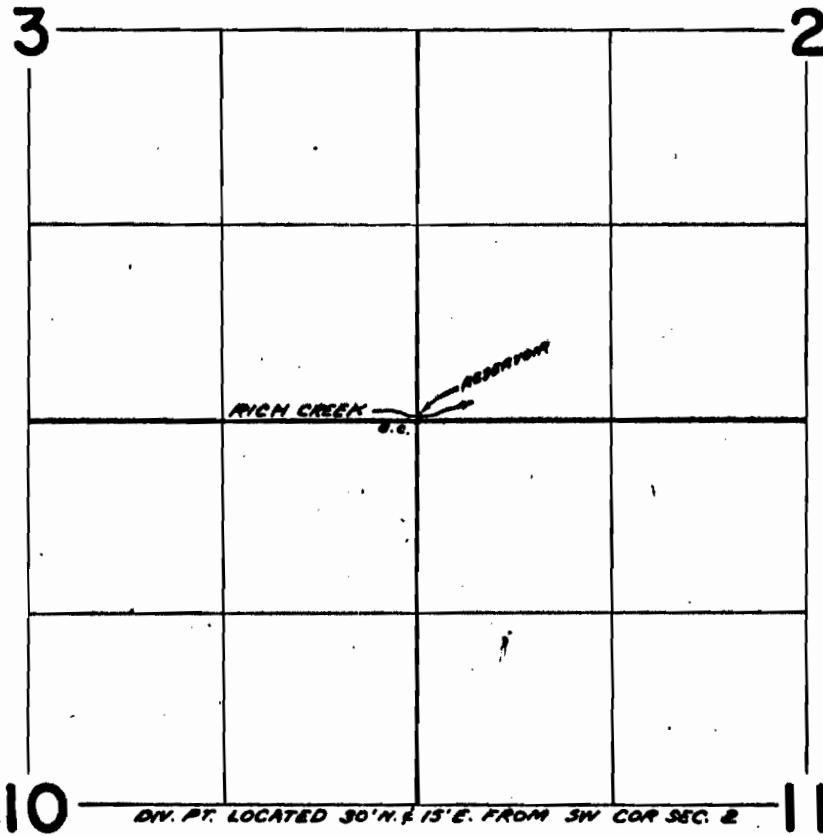

FINAL PROOF SURVEY
UNDER

Application No. 42440 Permit No. 31342
R-42551 R-4752
IN NAME OF

CHARLES E. & MARY TOYH SMITH

Surveyed JUN. 6 1969, by D. BUELL