


T. 35 S. R. 7 W. W. M.

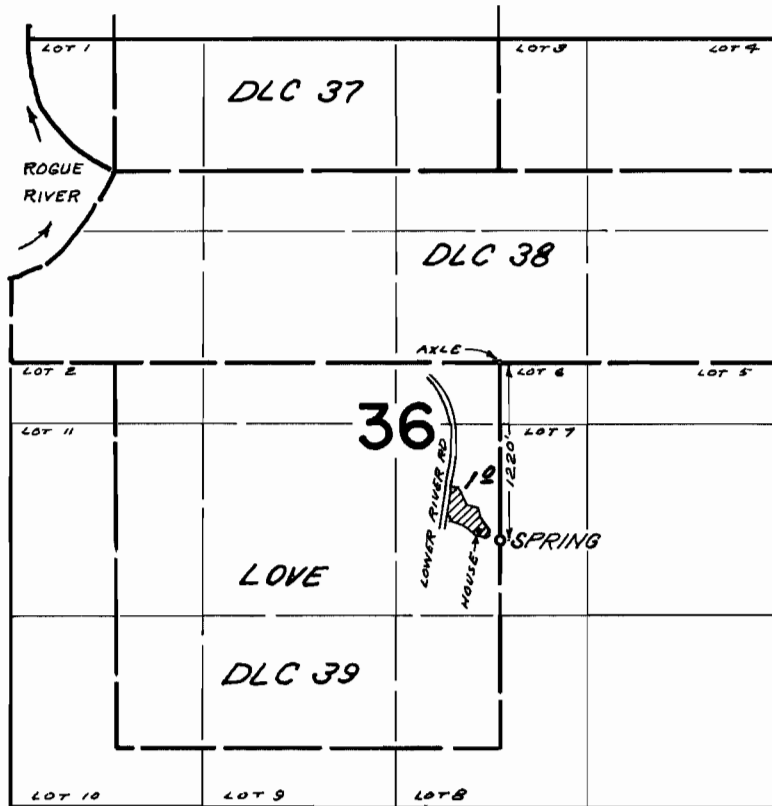

**FINAL PROOF SURVEY**  
UNDER

Application No. 37755 Permit No. 28550  
IN NAME OF

JOHN DANIEL & IDA BELLE SIMPSON

Surveyed JUN. 11 1969, by D. BUELL