
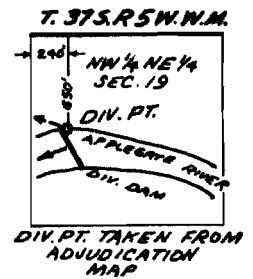


T. 37 S. R. 6 W. W.M.

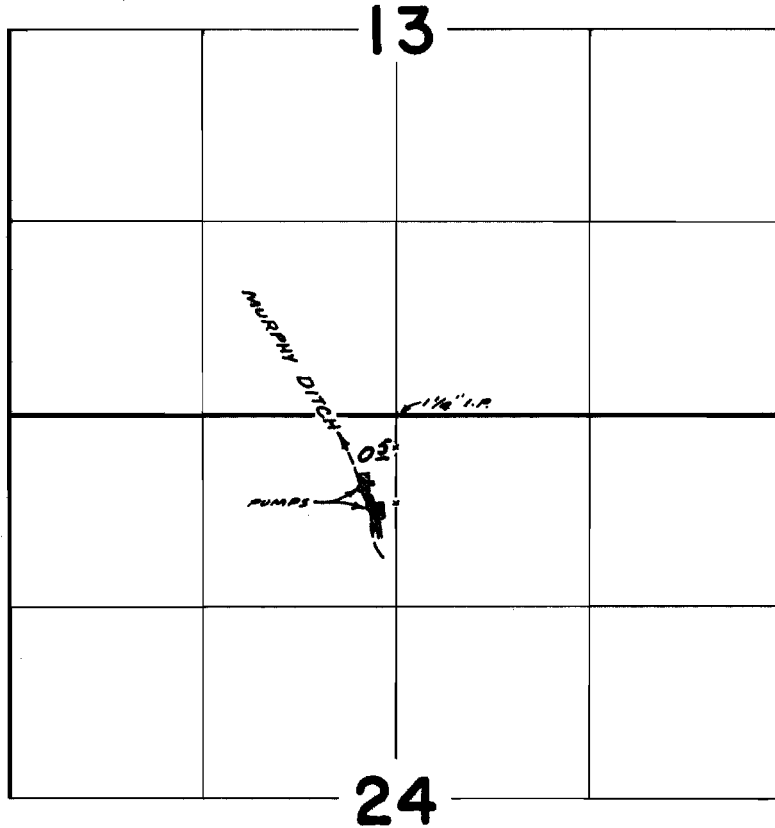

FINAL PROOF SURVEY
UNDER

Application No. 40913 Permit No. 30490
IN NAME OF

LOUIS & WATIE M. GARRETT

Surveyed JUN. 10 1969 by D. BUELL