


T. 36 S. R. 5 W. W. M.

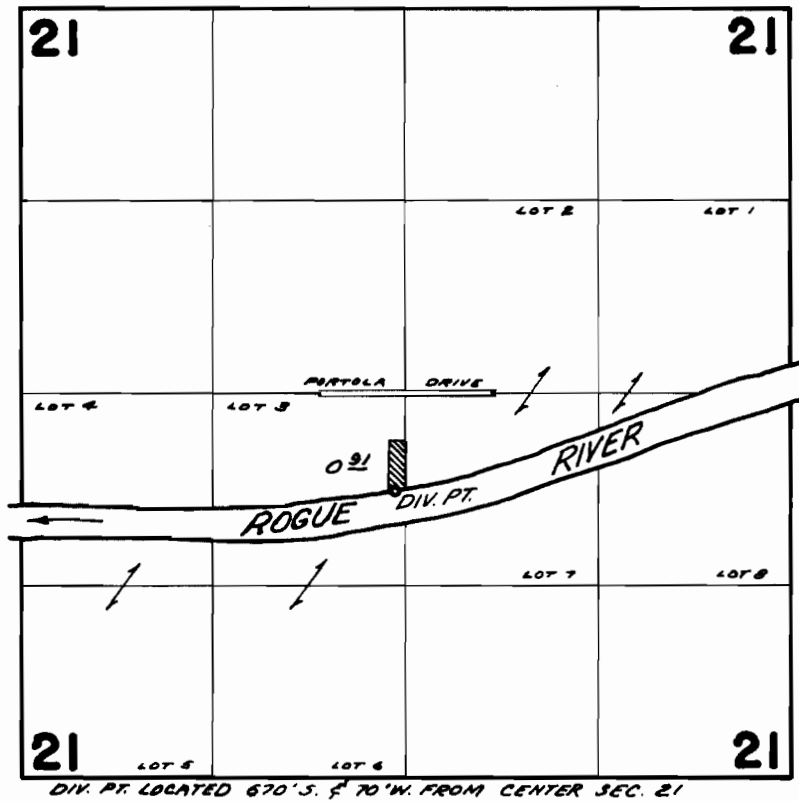

**FINAL PROOF SURVEY**  
UNDER

Application No. 43494 Permit No. 32532  
IN NAME OF

LLOYD M. HARLACHER

Surveyed JUN 6 1969, by D. BUELL