


T.40S. R.13E.W.M.

14
R-2266
37579
26317

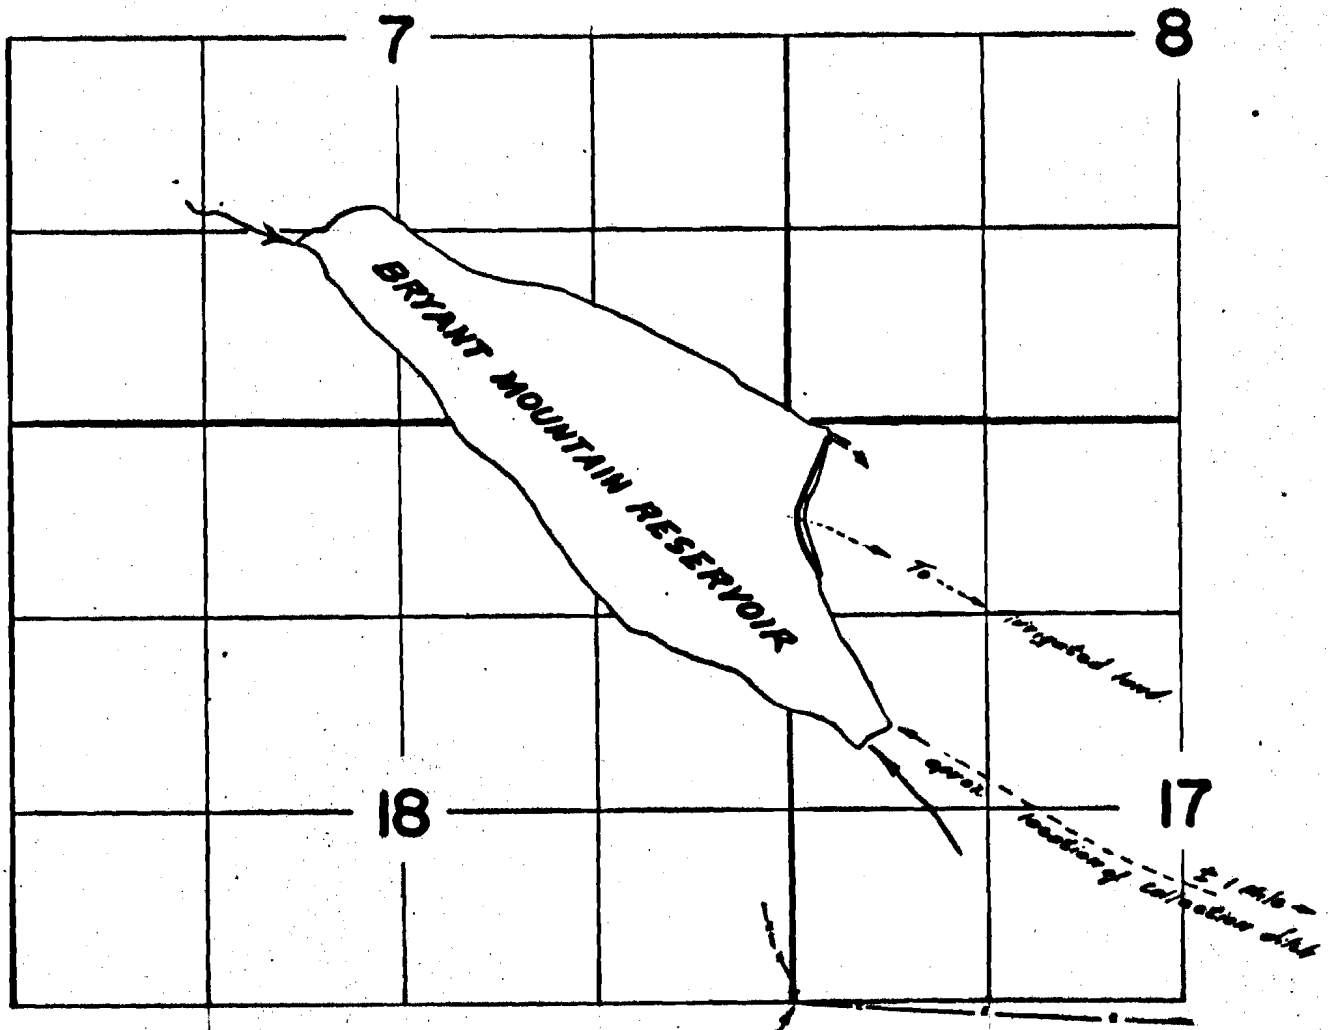

Division point located 3290 ft. N. & 50 ft. E. from S.W. Cor. NW 1/4 SW 1/4 Sec. 17.

FINAL PROOF SURVEY
UNDER

Application No. R-31785 Permit No. R-2266
IN NAME OF
ESTATE of WALTER SMITH,
JAMES C. STEVENSON, JR. &
MARGARET E. STEVENSON
Surveyed June 5, 1969, by W. L. Rappert

169-6