
14

26317
R-2266
37580

T.40S. R.13E.W.M

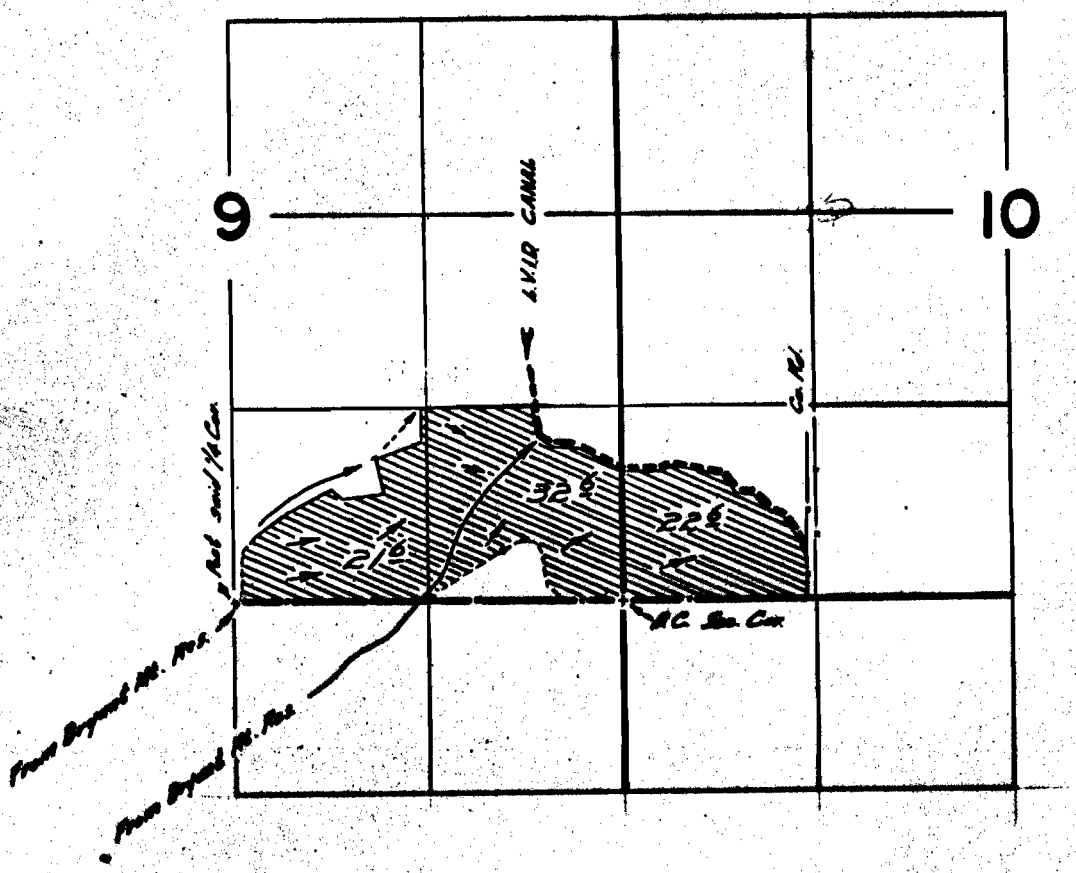


FINAL PROOF SURVEY
UNDER

Application No. 31786 Permit No. 26317
IN NAME OF
ESTATE of WALTER SMITH,
JAMES C. STEVENSON, JR. &
MARGARET E. STEVENSON
Surveyed June 5, 1969, by W. A. Haymond