


31122
37581

T. 39S. R. 8E. W.M.

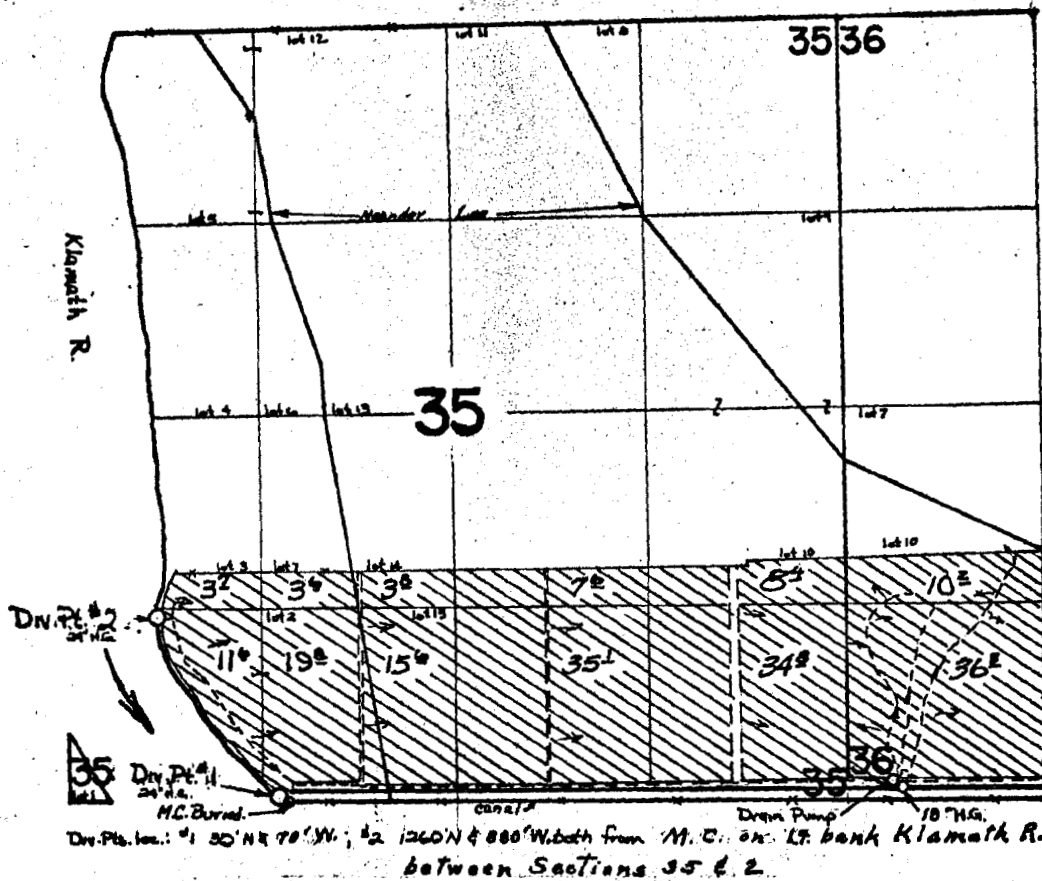

Klamath R.

FINAL PROOF SURVEY

UNDER

Application No. 40702 Permit No. 31122

IN NAME OF

SELMA FURBER & LEWIS E. FURBER

Surveyed 12 AUG 1970, by D. R. BUELL