


14
31441
37582

T.39S. R.8E. W.M.

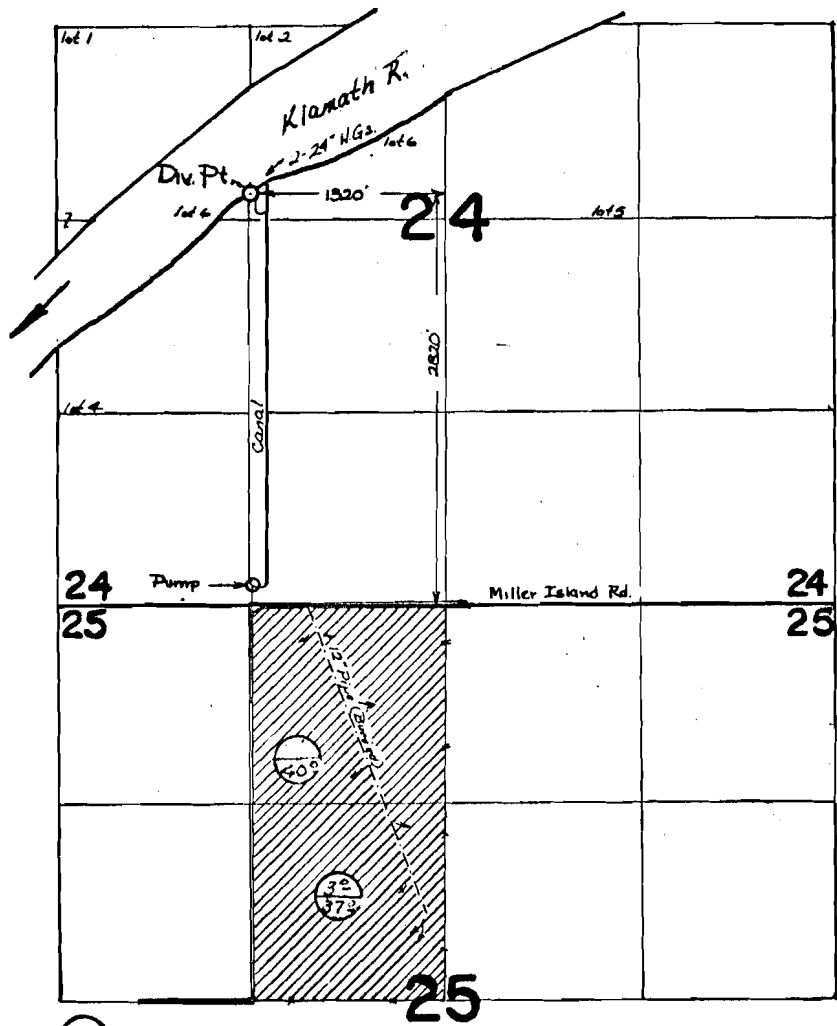

Klamath River

⊙ Primary
Supp. (Cert. 2809)

FINAL PROOF SURVEY

UNDER

Application No. 42011 Permit No. 31441

IN NAME OF

LEWIS E. FURBER

Surveyed 11 AUG 1970, by DR. BUELL