


14  
31442  
37583

# T. 39S. R. 8E. W. M.

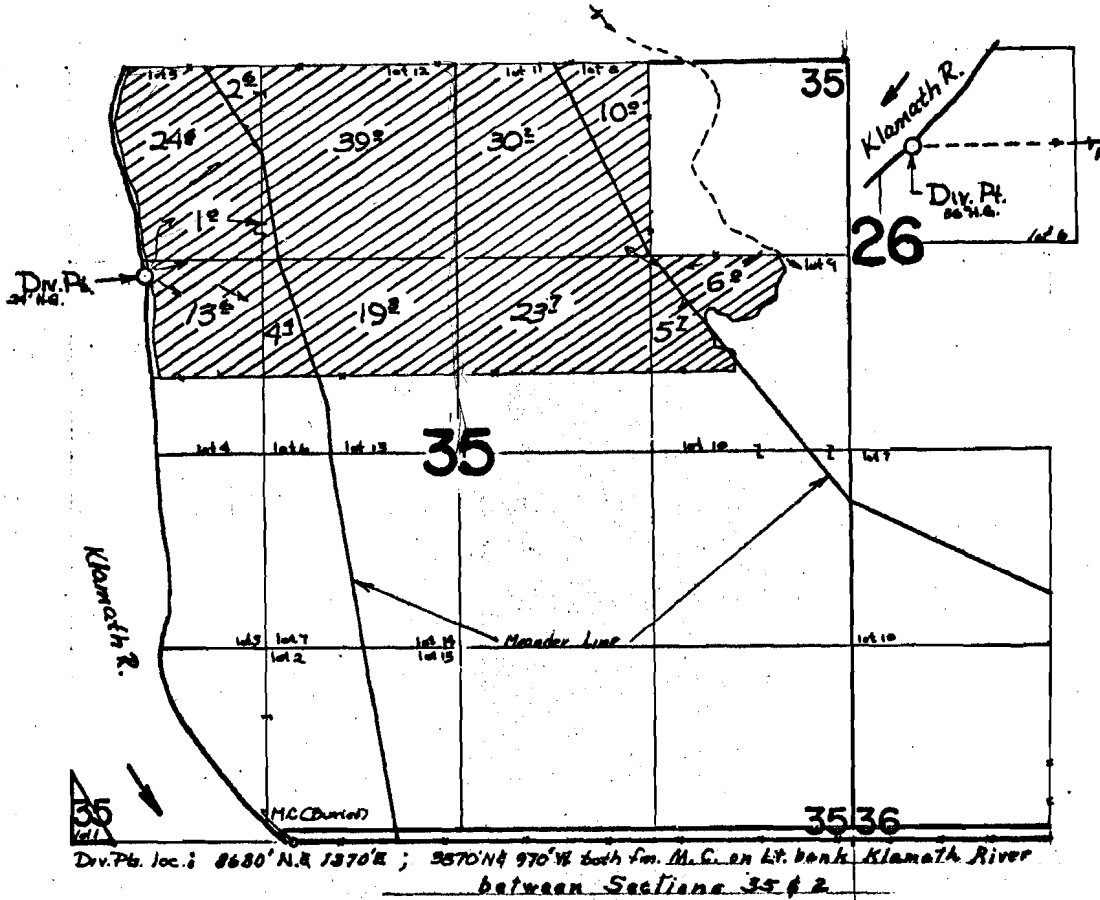

Klamath River

## FINAL PROOF SURVEY

UNDER

Application No. 42012 Permit No. 31442

IN NAME OF

**SELMA FURBER**

Surveyed 12 AUG 1970, by D. R. BUELL