


T. 38 S. R. 20 E. W. M.

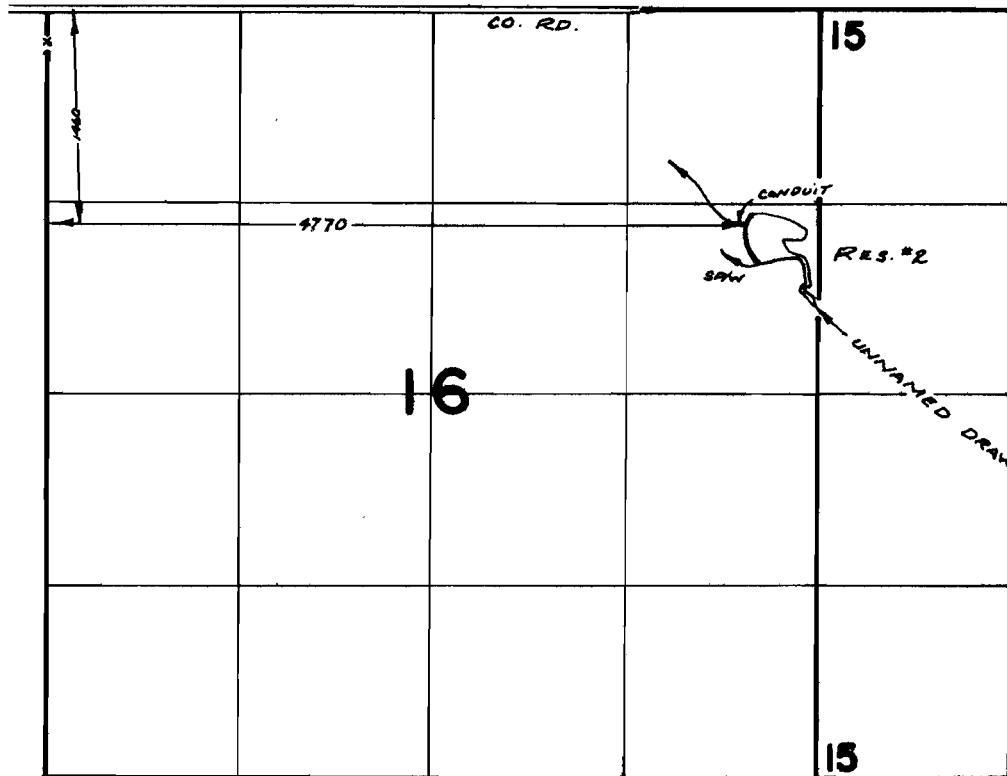

FINAL PROOF SURVEY

UNDER

Application No. R-41322 Permit No. R-4593

IN NAME OF

GLENN PLATO

Surveyed July 16, 1970, by R. MUCKEN