


27782
37589

T.408. R.I.E. W.M.

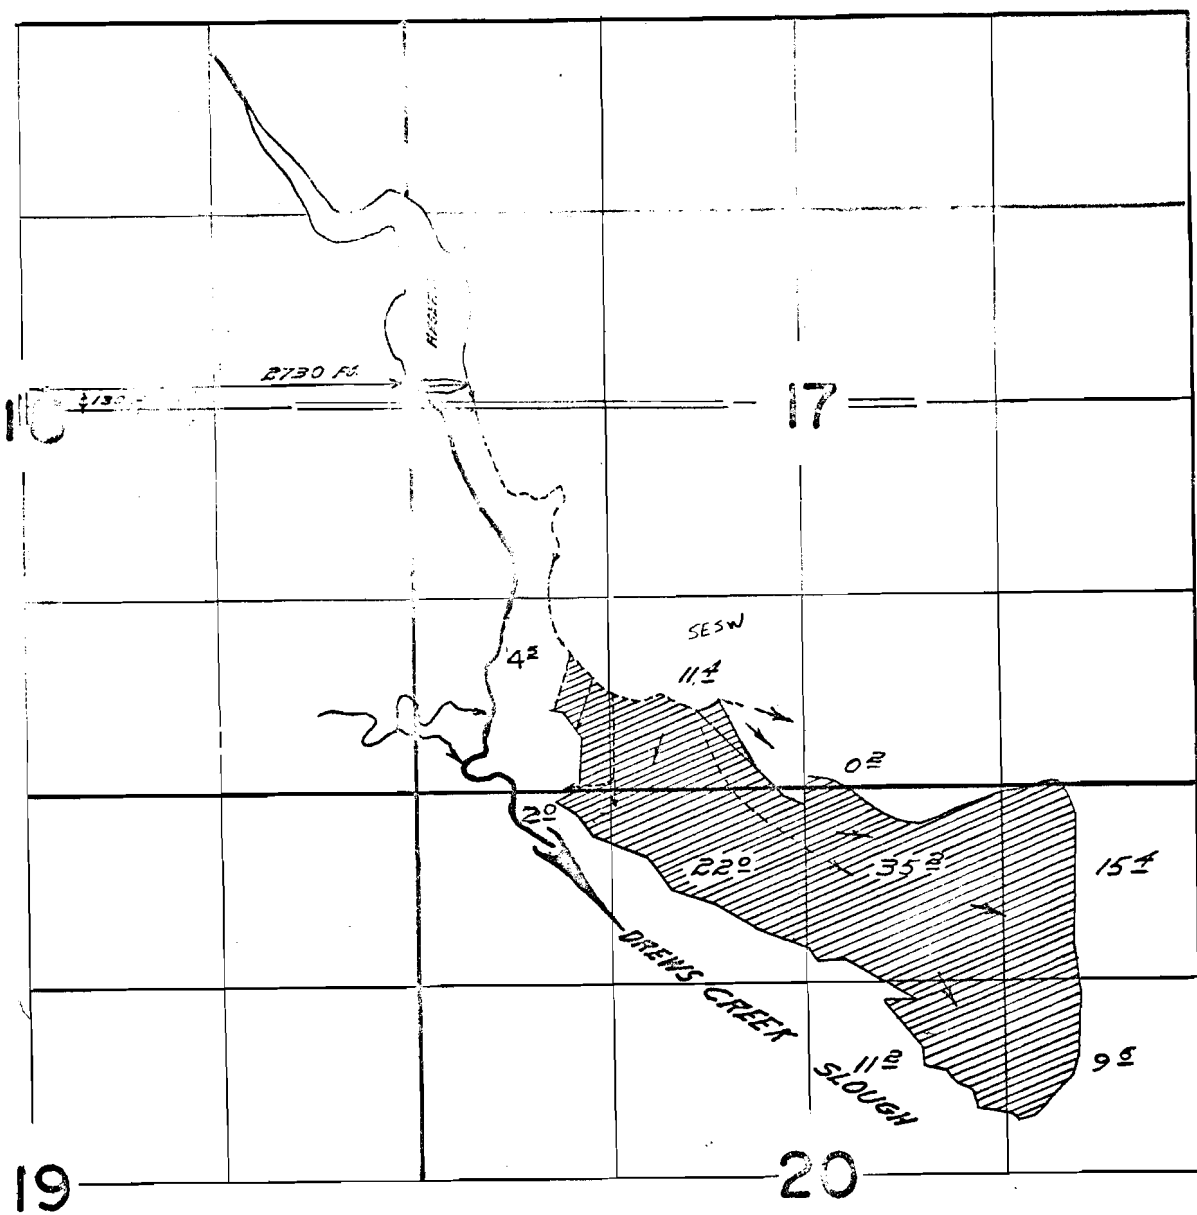

FINAL PROOF SURVEY
UNDER

Application No. 34749 Permit No. 27782
IN NAME OF

RALPH T. RENNER

JULY 30, 1968

Surveyed Aug. 30 1967, by W. D. Ruppel

40-19 ✓