


T.18S.R.2W.W.M.

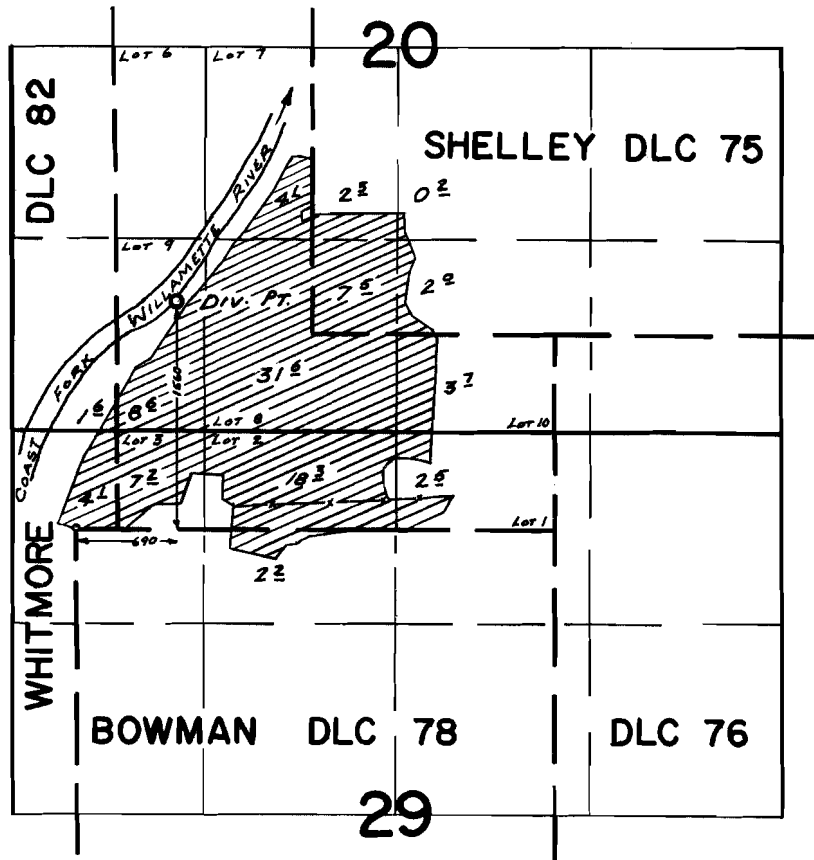

FINAL PROOF SURVEY UNDER

Application No. 39867 Permit No. 29499
IN NAME OF

STEVE J. HILGER

Surveyed APR. 30, 1969, by W. RUPPERT