


T.17 S. R.12 W. W.M.

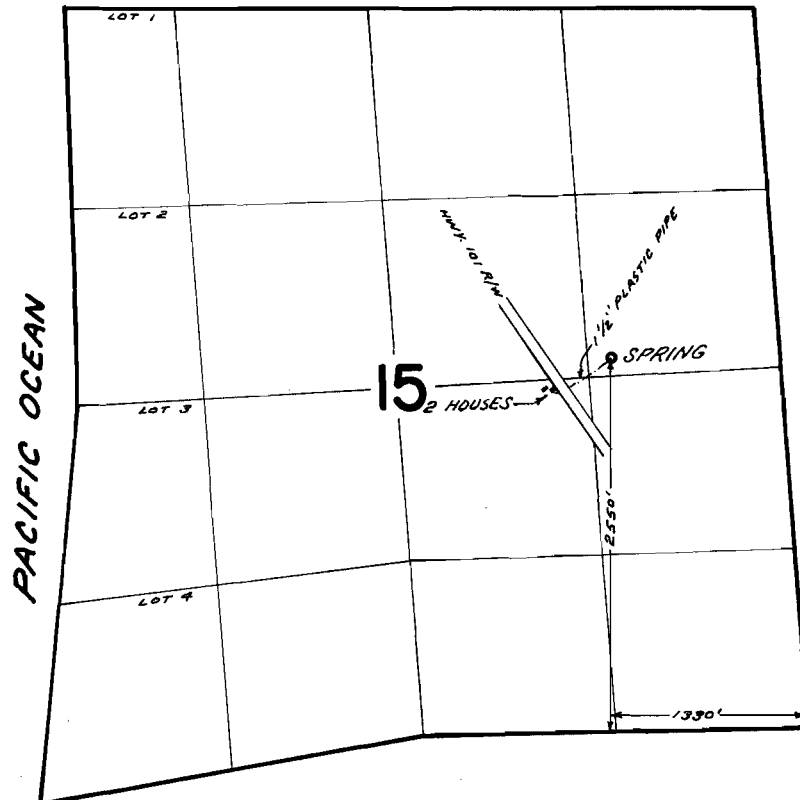

FINAL PROOF SURVEY
UNDER

Application No. 40846 Permit No. 30423
IN NAME OF

A. B. DOWNES

Surveyed AUG. 4 1969, by D. BUELL