T.11S.R.2W.W.M.

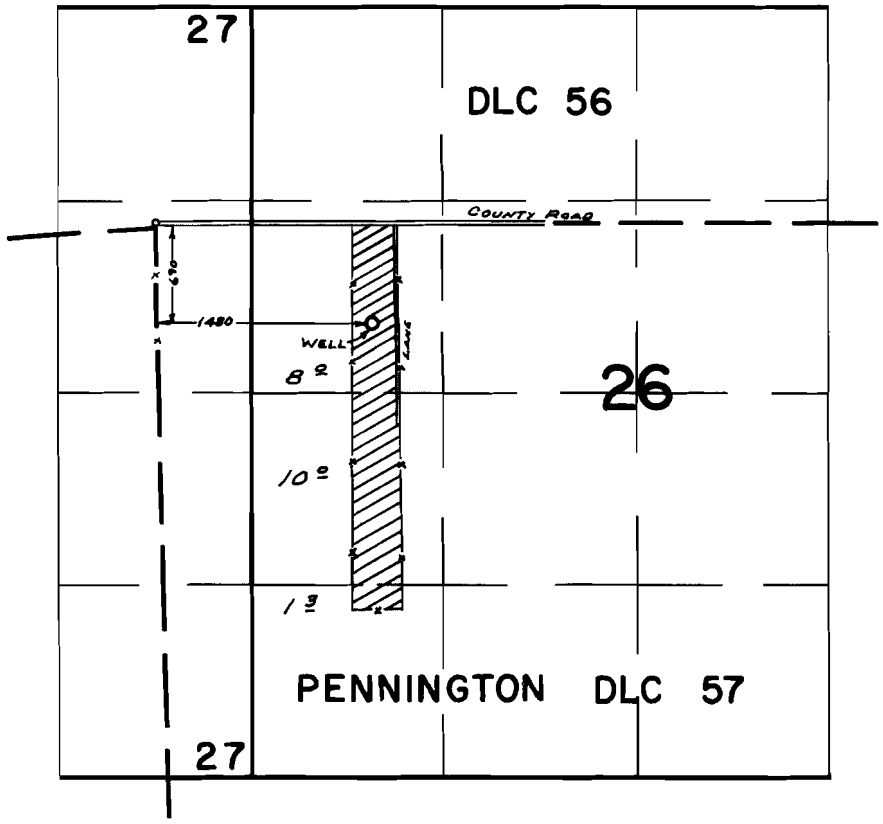

FINAL PROOF SURVEY
UNDER

Application No. G-2778 Permit No. G-2577
IN NAME OF

DUANE & RUBY HARTMAN

Surveyed MAY 29, 1969, by W. RUPPERT

B.M.
1967-L