




T.11S. R.2W.W.M.

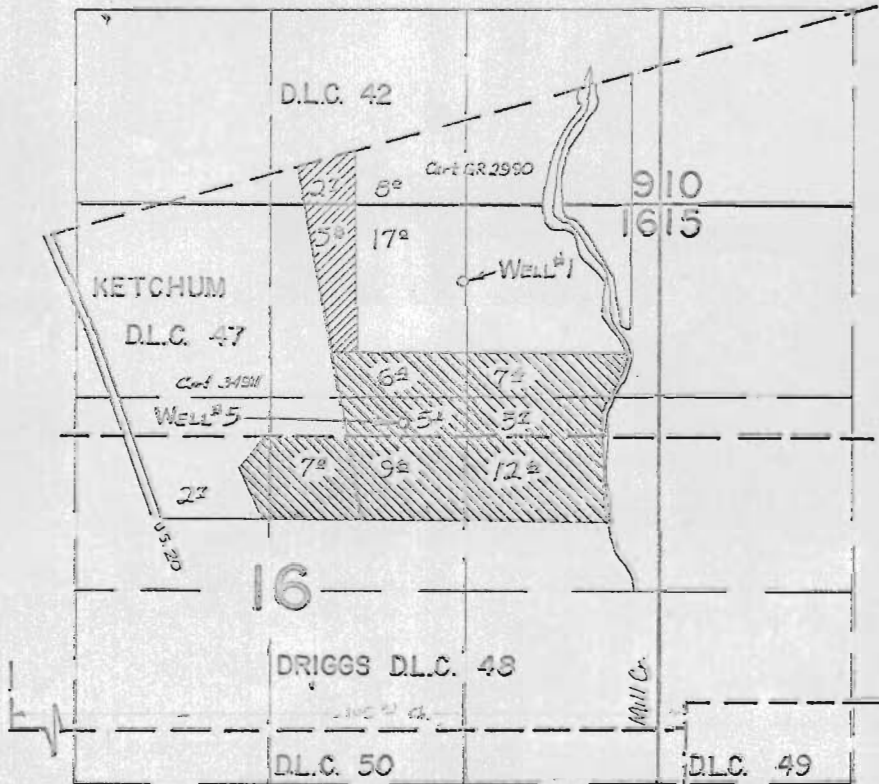

Well #1 Loc. 9110'N & 5420'E, Well #5 Loc. 2130'N & 5520'E both from S.E. Cor. Driggs D.L.C. 48.

-  Permit G 3123
-  Permit G 3124

FINAL PROOF SURVEY

UNDER

Application No. G 3322 Permit No. G 3123
G 3323 Permit No. G 3124

IN NAME OF

WEBBER & ELIDA DOUGHTON

Surveyed 2 APR 1970, by D.R. BUELL