


T.I.S.R.I.W.W.M.

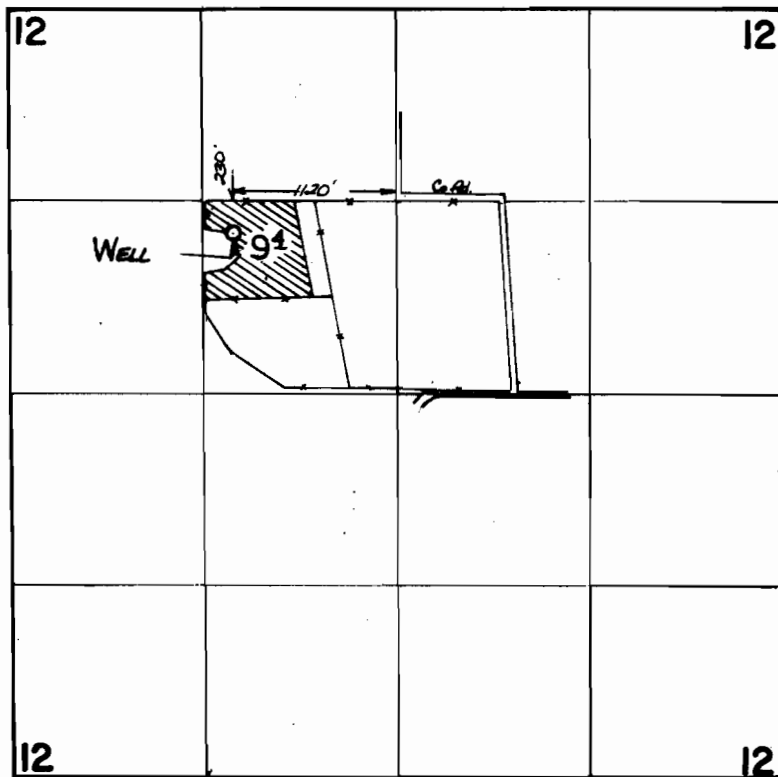

FINAL PROOF SURVEY

UNDER

Application No. **G 3746** Permit No. **G 3538**

IN NAME OF

W. C. & GERTRUDE I. WINGFIELD

Surveyed **8 APR** 19 **70**, by **D. R. BUELL**