


T.10S.R.3&4W.W.M.

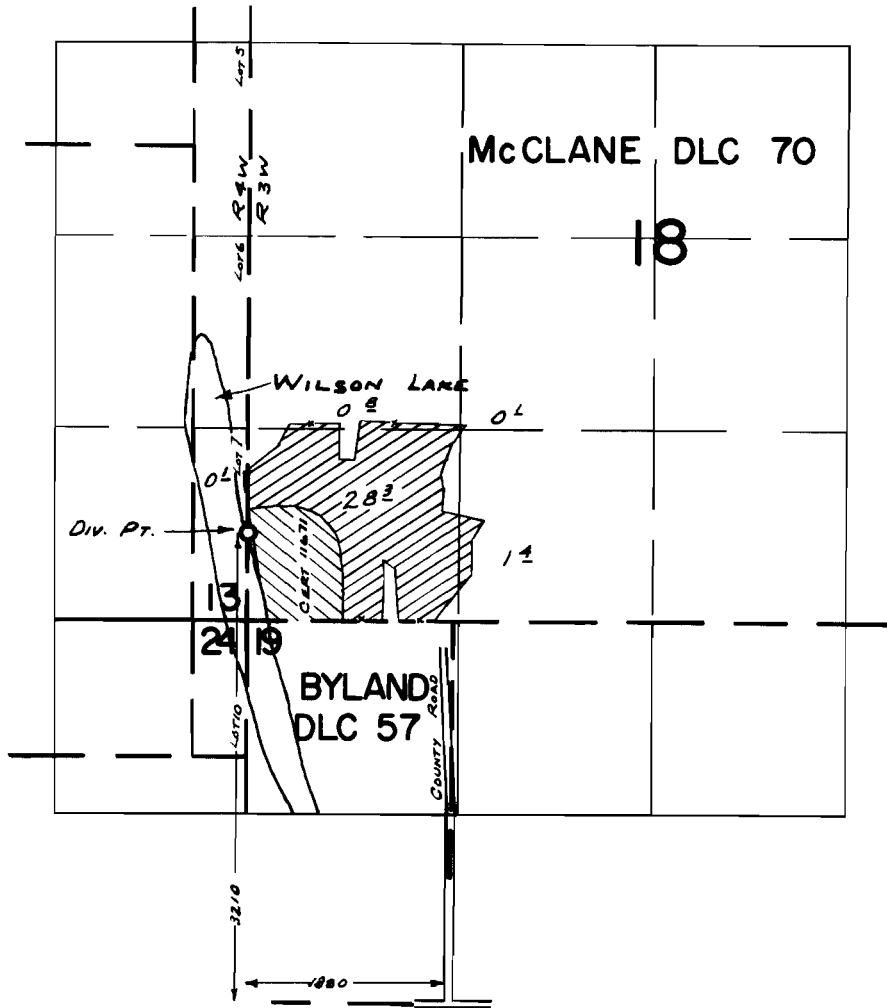

FINAL PROOF SURVEY
UNDER

Application No. 37580 Permit No. 27997

IN NAME OF
M. J. & CLARA E. HANSEN
& IVAN L. MUSTOE

Surveyed MARCH 21, 1969, by W. RUPPERT