


T10 & 11S.R.I.W.W.M.

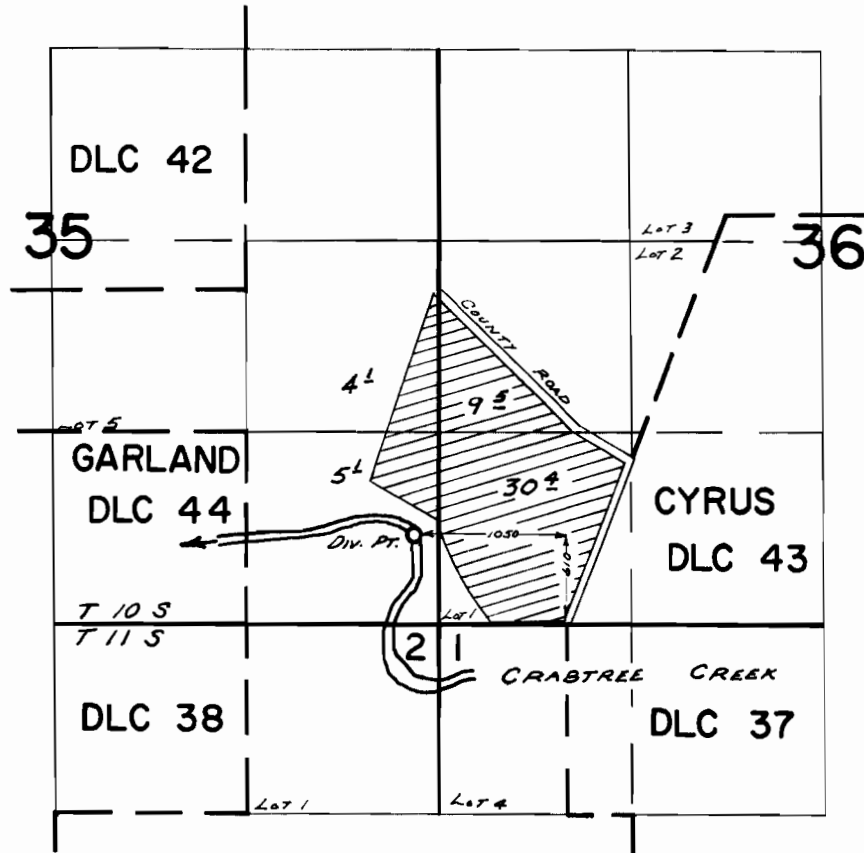

FINAL PROOF SURVEY UNDER

Application No. 38646 Permit No. 28763
IN NAME OF

PURMAN RICHEY

Surveyed JUNE 17, 1969, by W. RUPPERT.