


Per 1911
3766

T. 12 S., R. 21 E., W. M., Section 24, Quarter
Mapped by G.C. Blake Scale: 1 inch = 600 ft.

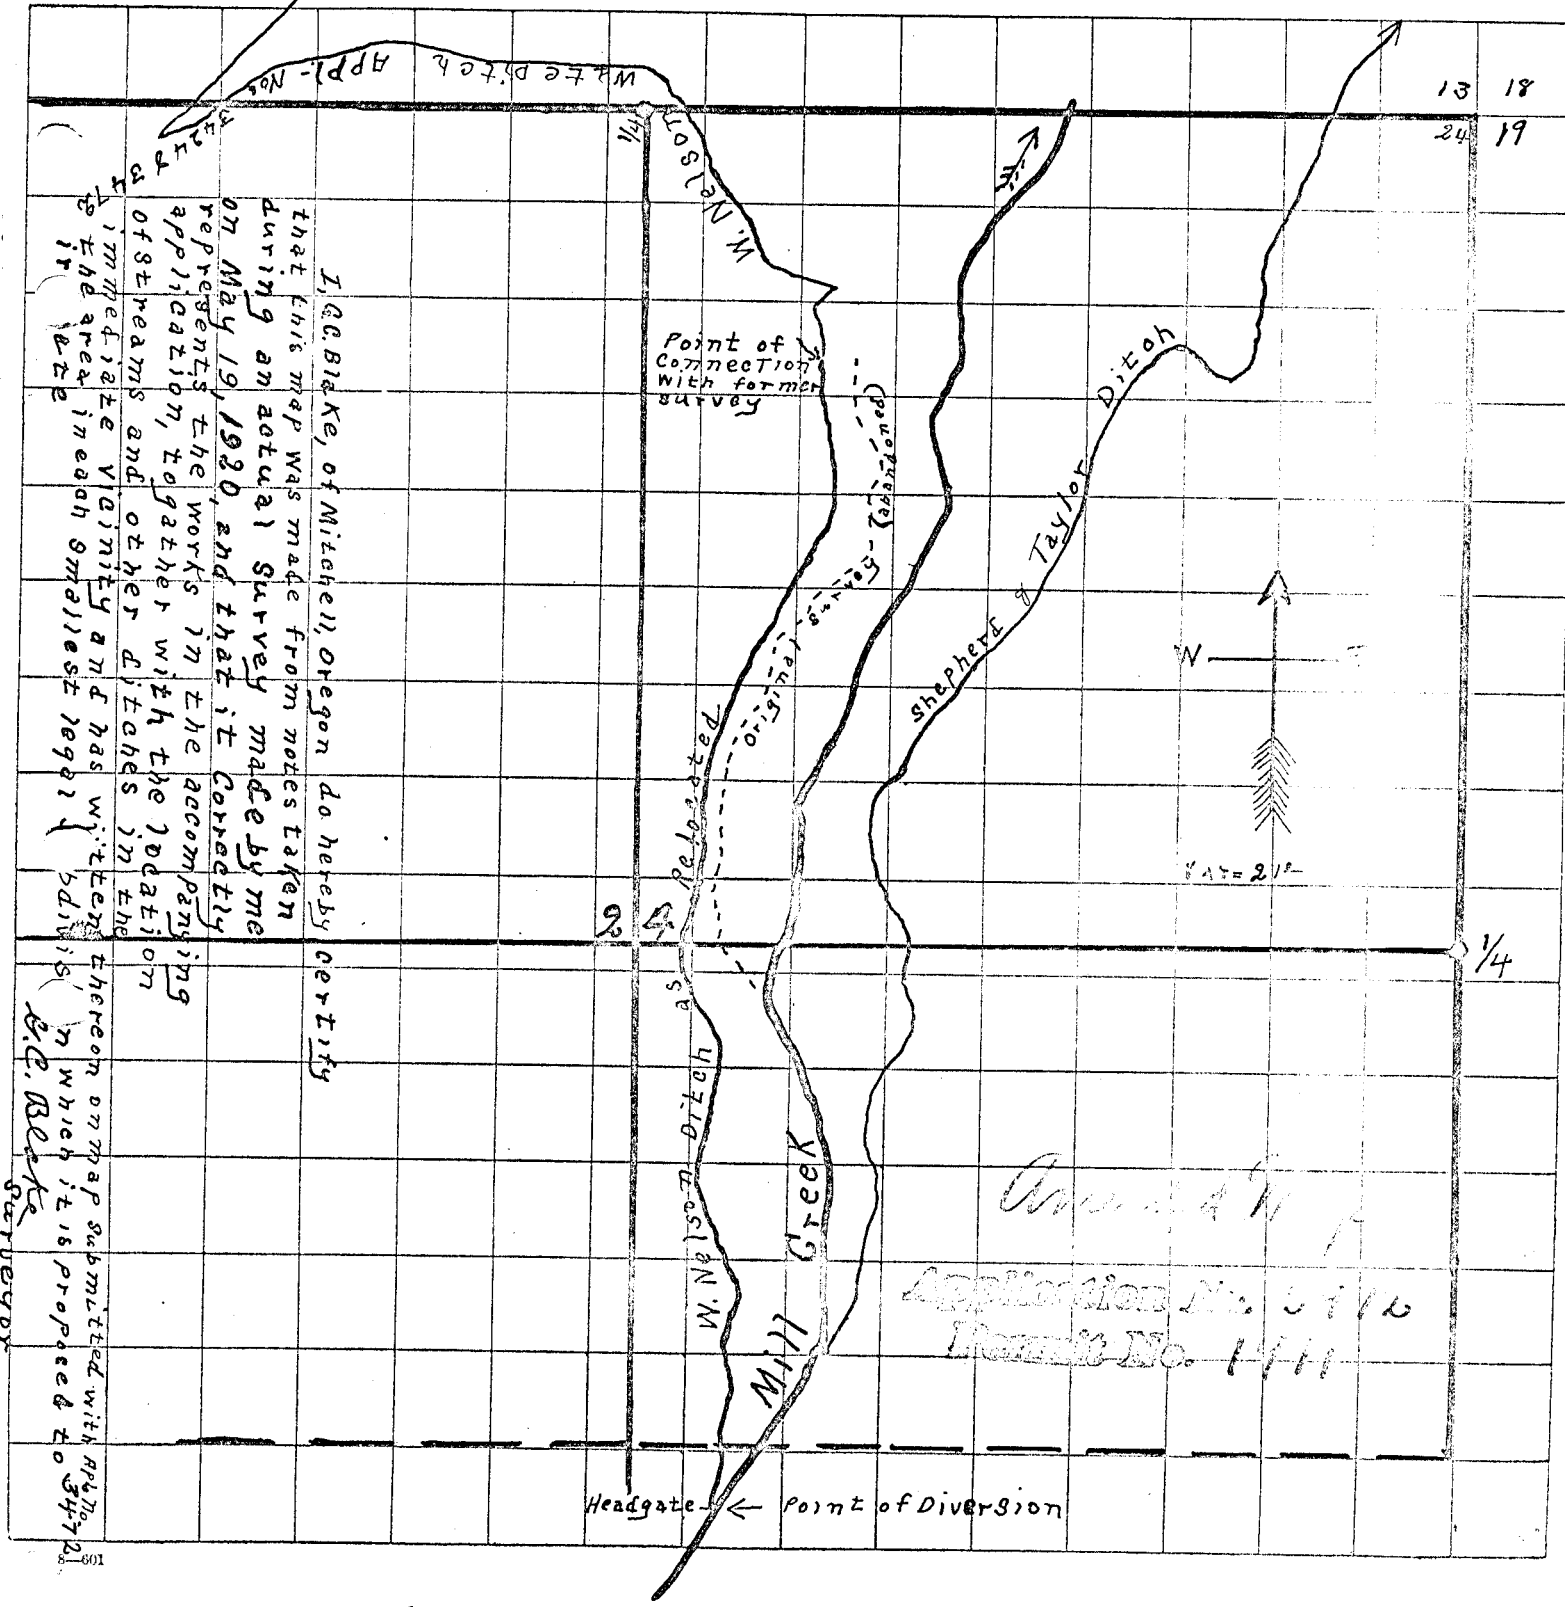

Approved by
Application No. 5416
Permit No. 1411


G.C. Blake
Surveyor