# T.14S.R.2W.W.M.

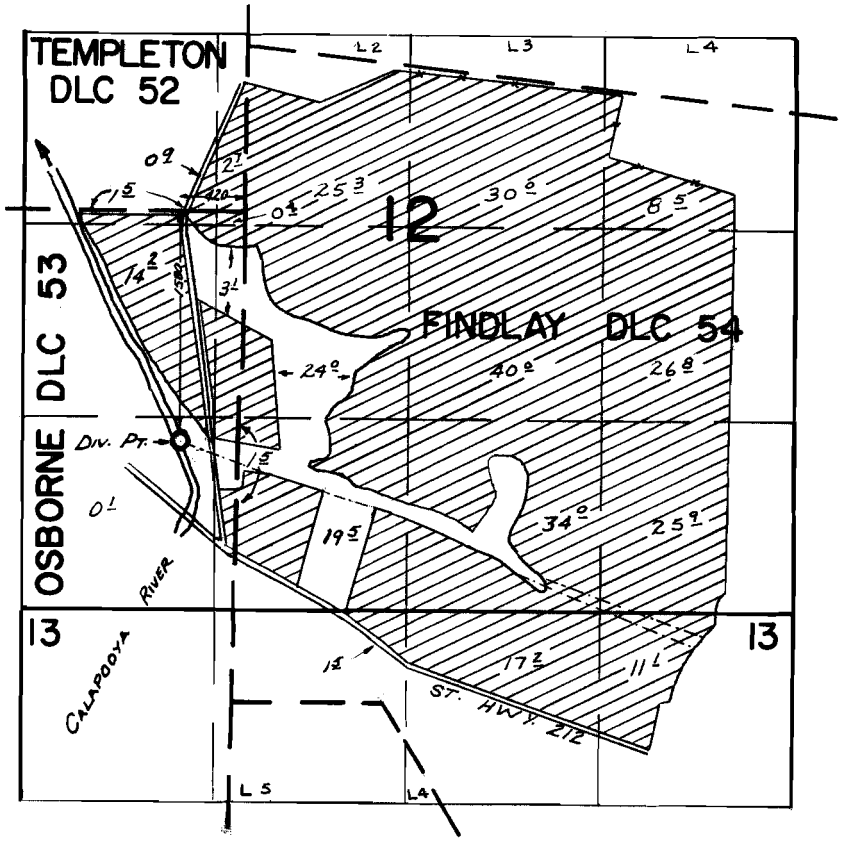


## FINAL PROOF SURVEY
UNDER

Application No. 40547 Permit No. 30219
IN NAME OF

LAWRENCE J. BERTSCH

Surveyed Sept. 17 19 69, by W. Ruppert

B.M.
DFM-20-51