


T.13S.R.IE.W.M.

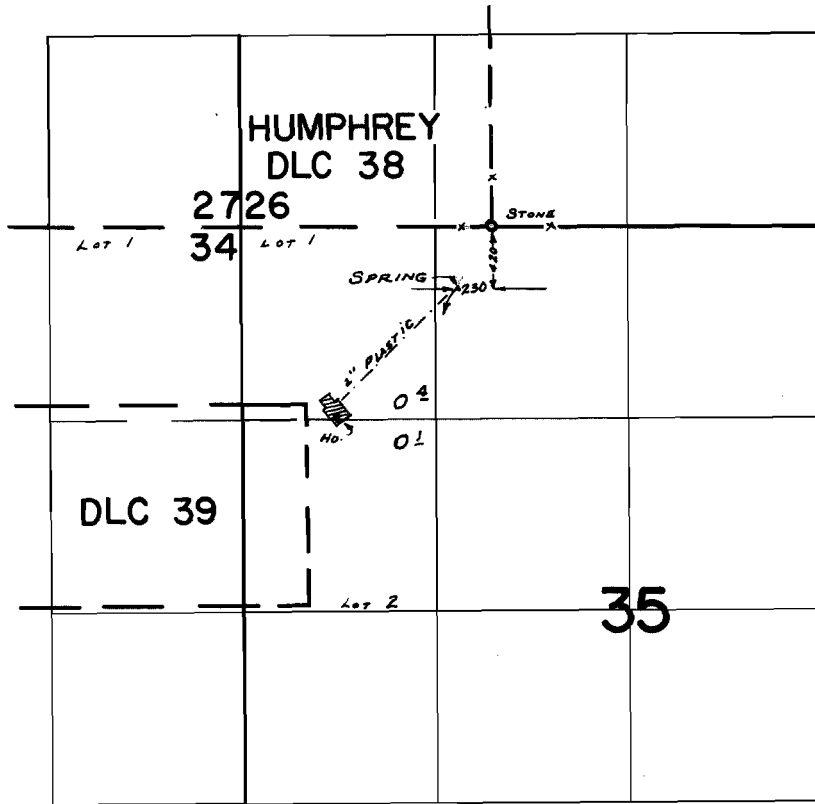

**FINAL PROOF SURVEY**  
UNDER

Application No. 40779 Permit No. 30388  
IN NAME OF

LOWELL C. FUNK

Surveyed APR 21, 1969, by W. RUPPART