


# T.I.S.R.I.W.W.M.

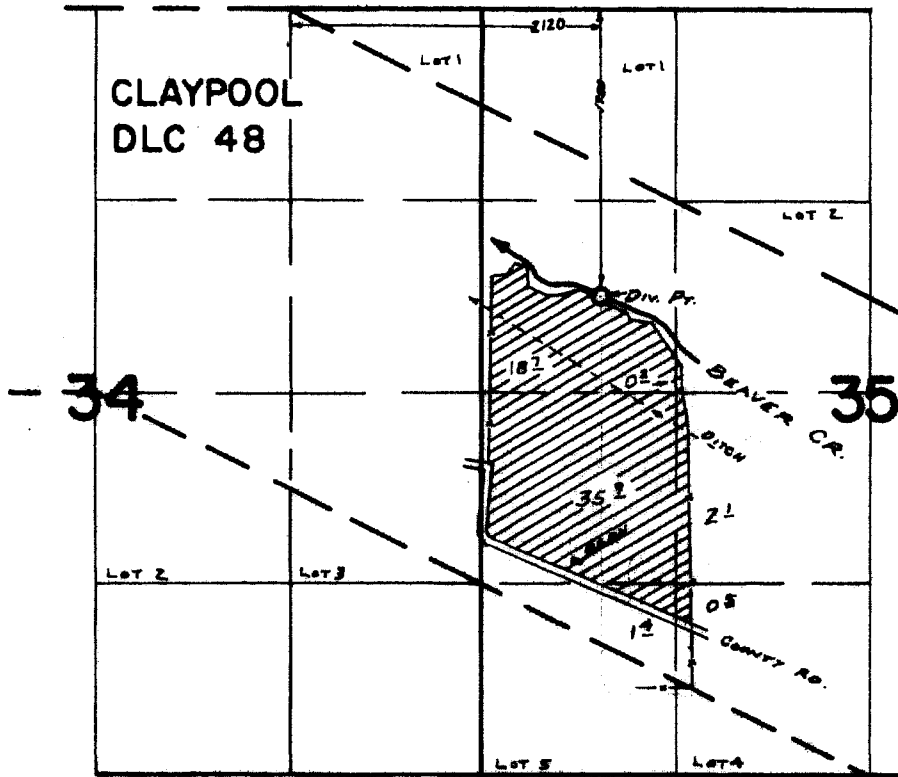

## FINAL PROOF SURVEY UNDER

Application No. 12087 Permit No. J1496  
IN NAME OF

NORMAN A. & EDITH MYRICK

Surveyed July 2, 1968, by W. RUREAT