


T.10S.R.2W.W.M.

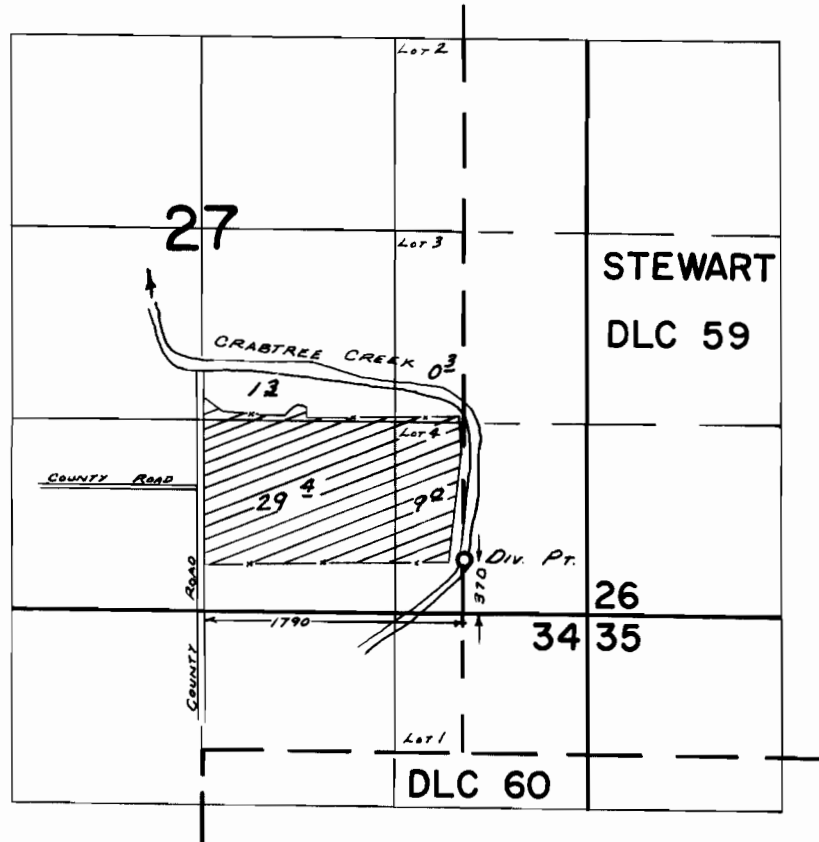

FINAL PROOF SURVEY UNDER

Application No. 42159 Permit No. 31550
IN NAME OF

ERNEST & VADA ORTIZ

Surveyed *MARCH 18, 1969*, by *W. RUPPERT*