


T. 13S. R. 2E. W. M.

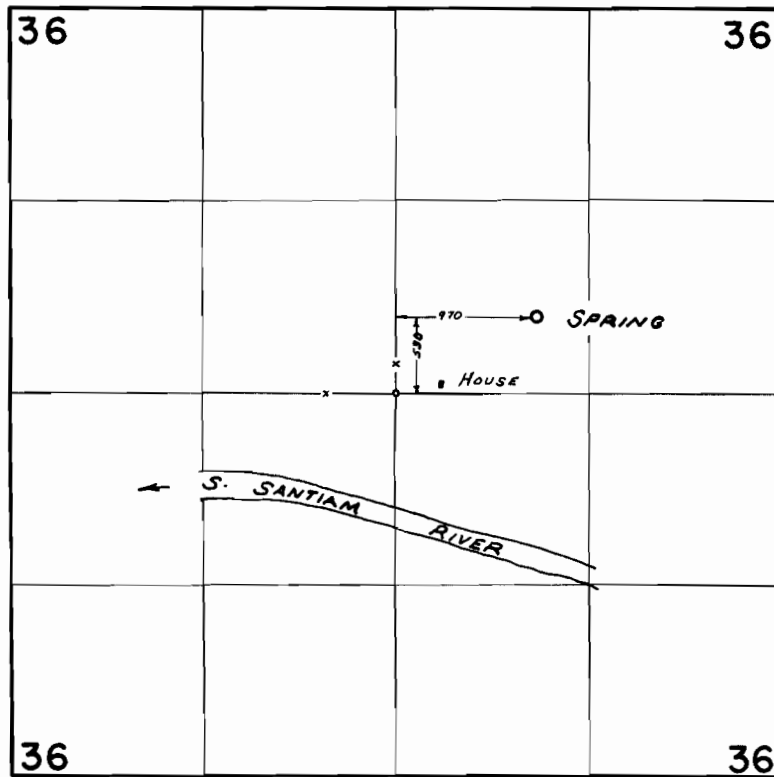

**FINAL PROOF SURVEY**  
UNDER

Application No. 42617 Permit No. 31834  
IN NAME OF

**MELVIN & GLADYS PAULUS**

Surveyed MAY 9, 1969, by W. RUPPERT