


T. I. S. R. I. W. W. M.

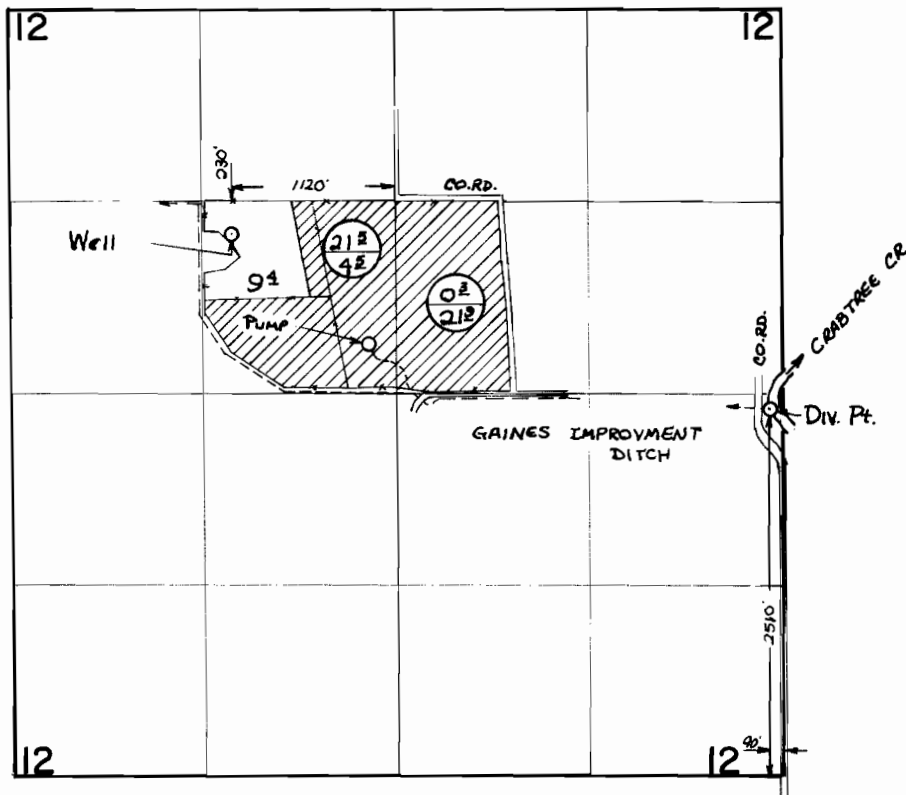

⊙ Permit 32209  
Permit 10519 Cert. 33893  
Unhatched area Permit G-3588

**FINAL PROOF SURVEY**  
UNDER

Application No. 43101 Permit No. 32209  
IN NAME OF

**W. C. & GERTRUDE I. WINGFIELD**

Surveyed 8 APRIL 1970, by D.R. BUELL