


T.18 S. R. 47 E. W. M.

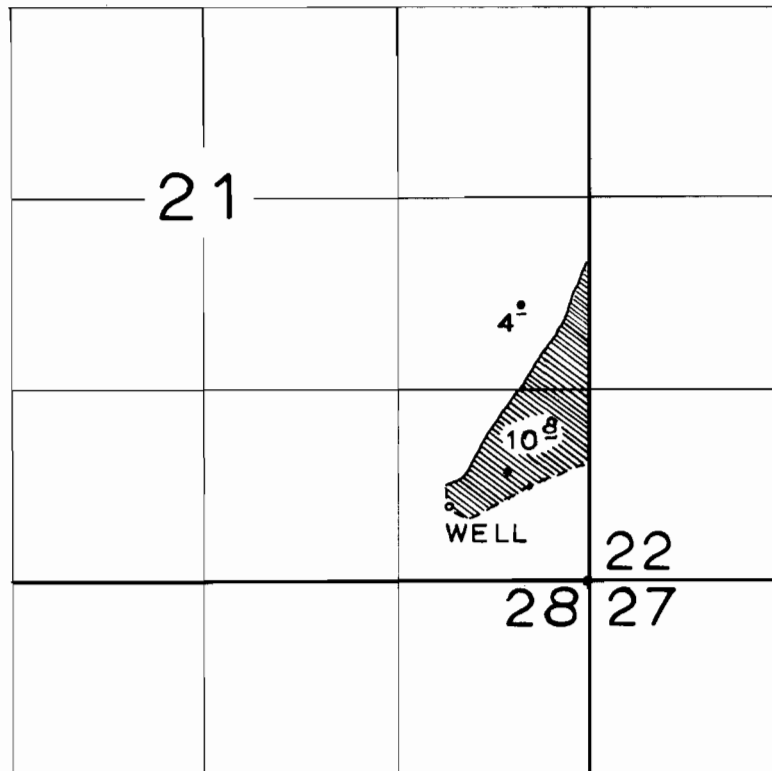

WELL IS 525' N. & 960' W. FROM SE. COR. SEC. 21

FINAL PROOF SURVEY
UNDER

Application No. G-3727. Permit No. G-3452.
IN NAME OF

JAY N. AND EDITH MAE HOLLIDAY

Surveyed MAR. 15, 1968, by F. E. FERING