


T.18 S. R. 47 E. W.M.

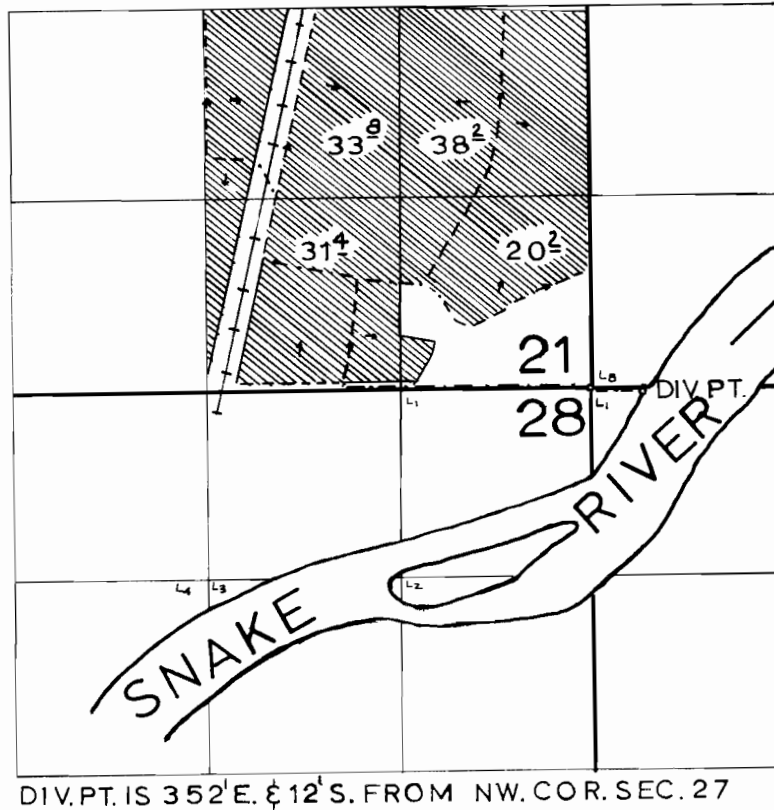

FINAL PROOF SURVEY
UNDER

Application No. 43050 Permit No. 32142
IN NAME OF

JAY N. AND EDITH MAE HOLLIDAY

Surveyed MARCH 15 1968, by F. ELFERING