


T.18S.R.47E.W.M.

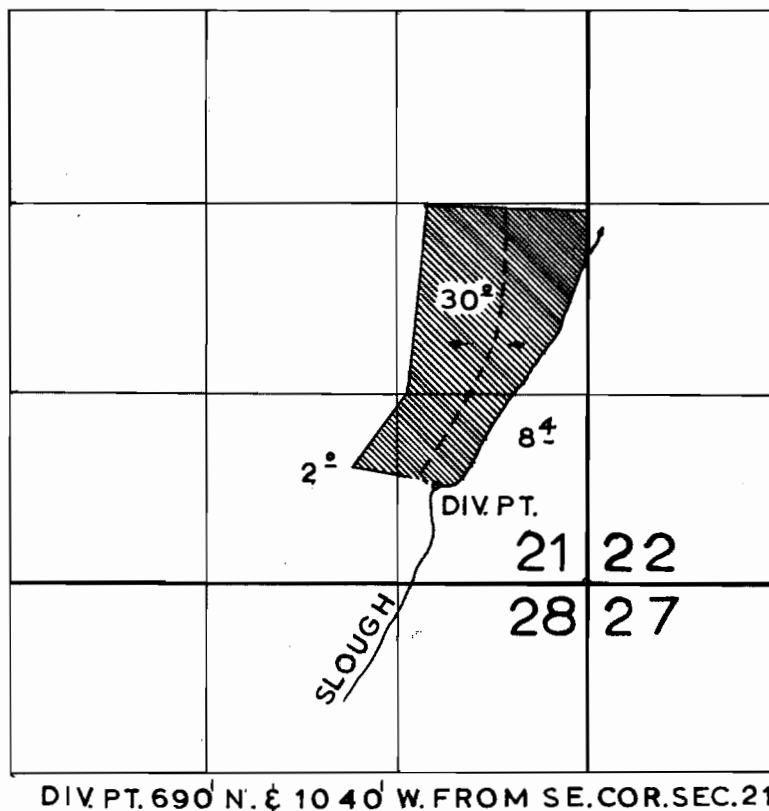

$DIV. PT. 690' N. \& 1040' W. FROM SE. COR. SEC. 21$

FINAL PROOF SURVEY
UNDER

Application No. 43051... Permit No. 32143....
IN NAME OF

JAY N. AND EDITH MAE HOLLIDAY

Surveyed MAR.15 1968, by F.E.L.FERING....