


T.18 S.R.45 E.W.M.

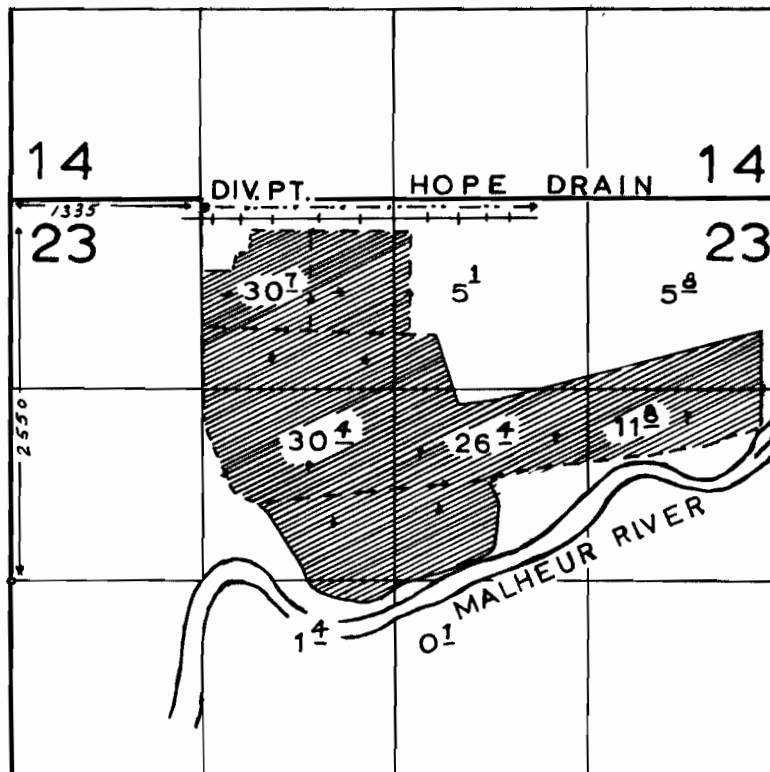

FINAL PROOF SURVEY
UNDER

Application No. 44299... Permit No. 33085...
IN NAME OF

ROBERT C. MARQUIS

Surveyed OCT. 15... 1970, by E. ELFERING