


T.14S.R.8W.W.M.

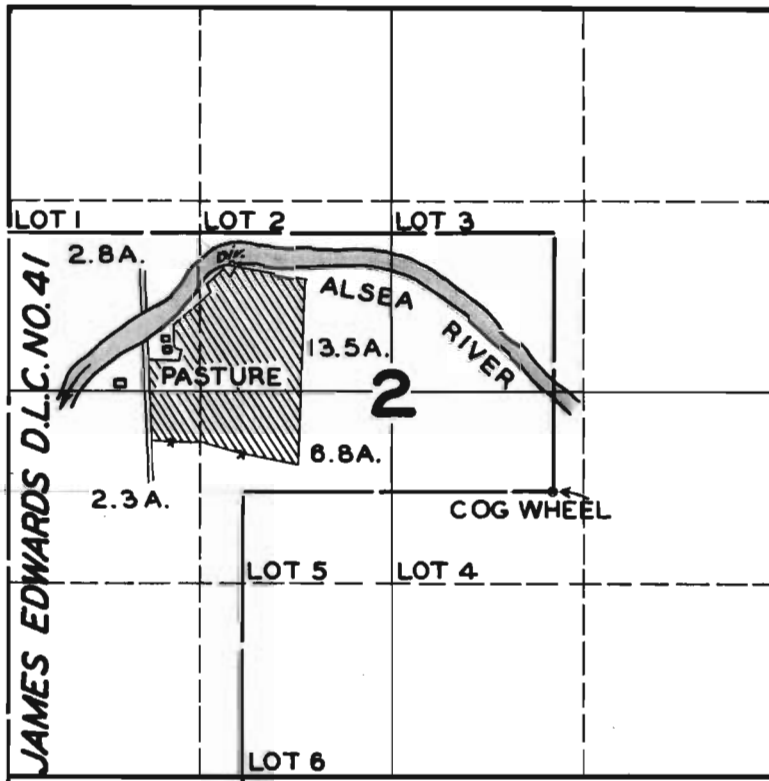

FINAL PROOF SURVEY
UNDER

Application No. **19709** Permit No. **15285**
IN NAME OF

H.L. HAYDEN

Surveyed **JUNE 29 1947**, by **JAS. E. BUNNELL**