


T.1&2S.R.2E.W.M.

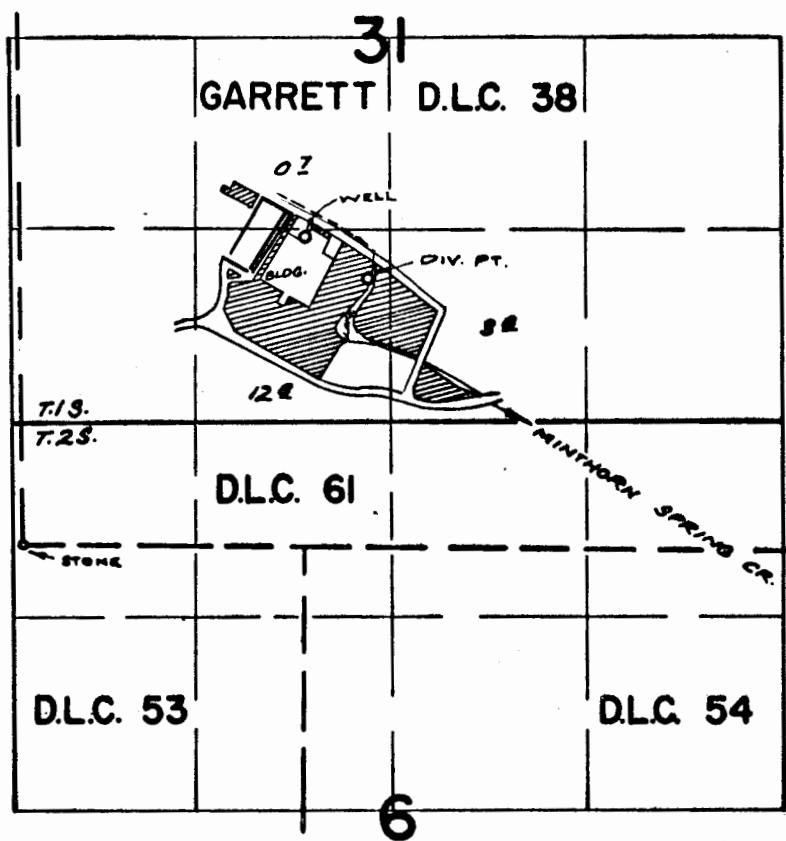

WELL LOG: 1900' E. & 2070' N. FROM S.W. COR. GARRETT D.L.C. 61
 DIV. PT. LOG: 2000' E. & 1800' N.

FINAL PROOF SURVEY UNDER

TRANSFER No. 0-54

Application No. ~~G-9235~~ ^{G-9547} Permit No. ~~G-4276~~ ^{G-3401}

IN NAME OF

OMARK PROPERTIES, INC.

Surveyed Nov. 6, 1970, by L. E. GAULD.